

DEC 27 1999

Approved by Alger County
Land Survey Remonumentation
Peer Group Under Act 345 of
P.A. of 1990 On 12-8-1999

Yusef Wilson
Chairman

LAND CORNER RECORDATION CERTIFICATE
Filing Requirement of Act 74, Mich. P.A. 1970

For corners in

SECTION

Alger

(County)

Located In:

Corner Code #

05-182


- 1. Public Land Survey T 46N R 17W D3
- T R
- T R
- T R
- 2. Property Controlling S T R
- in Section S T R
- 3. Miscellaneous S T R
- Property in Section S T R

FILED
TIME 1:30 pm

DEC 15 1999

DONALD W. KINNUNEN
REGISTER OF DEEDS
ALGER COUNTY, MI
Register of Deeds Stamp & File Number

- 4. Lot No. _____, Recorded Plat _____
- 5. Private Claims _____

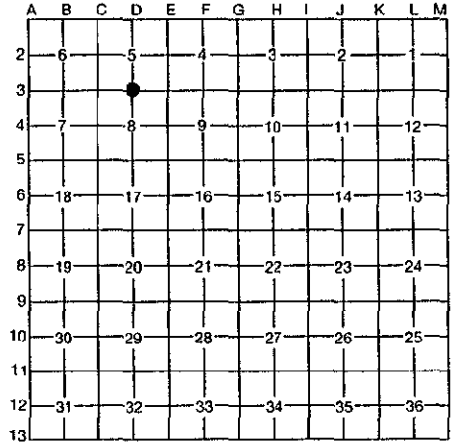

I, Robert L. Janros, in a field survey on October 12, 1999, 19 _____ do hereby state that under requirements of P.A. 74, Michigan P.A. of 1970, the corner points mentioned in lines 1 and 2 above were in conformance with regulations and rules therefore as required in the current manual of survey instructions of the United States Department of the Interior, Bureau of Land Management or by a decree of a Court of Law and/or that the corner points mentioned in lines 3, 4 and 5 above were in conformance with the rules of the Michigan Board of Land Surveyors or by a Decree of a Court of Law; established, re-established, monumented, _____ recovered, found as expressed below:

NOTE: Not more than 2 corners, all in the same town and range, may be recorded on this certificate.

A. Description of original monument and accessories and/or subsequent restoration:
D3: PLS * William Ives, DS, 1850. * Set quarter section post. * Sugar 7", N.55 E., 06 links. * Sugar 12", S.07 E., 41 links. **** George L. Depew, CS, 1919. * Ran South line of Section 5, T46N, R.17W, and set iron corner at South 1/4 section corner at Station 26+45. * No references given.* Book 7, Alger County Road Commission, Alger County Records. **** Michael Mileski, PS, 1997. * Reestablished corner mid way and on line between section corners East and West. * Set 1/2"x18" iron rod with plastic cap. * Power pole, S.84 E., 109.67 feet. * 8" Balsam, S.02 W., 42.77 feet. * Power pole, N.70 W., 87.43 feet. * Southeast corner of house, N.36 W., 117.29 feet. * Liber 5, Page 3, Alger County Corner Records. **** No other subsequent restoration of record.

B. Description of corner evidence found and/or method applied in restoring or reestablishing corner:
D3: Located corner search area by calculated position and standard field survey methods. Found 1/2" iron rod and 4 references of the 1997 report in good condition. A search was made for the Alger County monument set in 1919, monument presumed to be destroyed by road construction. Existing 1/2" iron rod found to be at midpoint and on line between Section corners 1/2 mile east and 1/2 mile west. Replaced existing 1/2" iron rod with new monument and renewed existing references. Existing monument as found is accepted as a careful and faithful reestablishment of the position of the original corner.

C. Description of monument for corner and accessories established to perpetuate locating the position of the corner:
D3: Set 5/8"x18" rebar with Berntsen 3 1/4" aluminum cap No. RBD5325 in place of the 1/2" iron rod. * Stamped monument cap to identify corner position.* Renewed existing references as follows: Existing - Southeast corner of garage, N.28 W., 117.29 feet. * Set PK nails with aluminum I.D. washers for measure in the following: Power pole, S.80 E., 109.67 feet. * Balsam 6", S.07 W., 42.68 feet. * Power pole, N.62 W., 87.43 feet. * All bearings are magnetic.



Signed by *Robert L. Jamros*
Surveyor's Michigan License No. 25849

Date Dec 13, 1999