

FEB 19 1998

Approved by Alcona County  
Land Survey Remonumentation  
Peer Group Under Act 645 of  
P.A. of 1990 On 12-10-1997

SECTION

05-56

Gerald W. Carlson  
Chairman

LAND CORNER RECORDATION CERTIFICATE  
Filing Requirement of Act 74, Mich. P.A. 1970

For corners in

(County)	Located In:	Corner Code #
1. Public Land Survey	T <u>46</u> R <u>17</u>	D7
	T _____ R _____	_____
	T _____ R _____	_____
	T _____ R _____	_____
2. Property Controlling in Section	S _____ T _____ R _____	_____
	S _____ T _____ R _____	_____
3. Miscellaneous Property in Section	S _____ T _____ R _____	_____
	S _____ T _____ R _____	_____

FILED  
TIME 8:30 A.M.


DEC 17 1997

DONALD W. KINNUNEN  
REGISTER OF DEEDS  
ALCONA COUNTY, MI

Register of Deeds Stamp & File Number

4. Lot No. \_\_\_\_\_, Recorded Plat \_\_\_\_\_  
5. Private Claims \_\_\_\_\_

I, Robert L. Jamros, in a field survey on November 25, 1997, 19\_\_\_\_\_, do hereby certify that under requirements of P.A. 74, Michigan P.A. of 1970, the corner points mentioned in lines 1 and 2 above were in conformance with regulations and rules therefore as required in the current manual of survey instructions of the United States Department of the Interior, Bureau of Land Management or by a decree of a Court of Law and/or that the corner points mentioned in lines 3, 4 and 5 above were in conformance with the rules of the Michigan Board of Professional Surveyors or by a Decree of a Court of Law; established, re-established, monumented, re-monumented, recovered, found as expressed below:

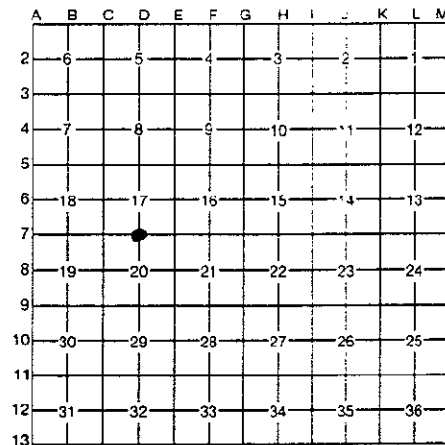

NOTE: Not more than 4 corners, all in the same town and range, may be recorded on this certificate.

A. Description of original monument and accessories and/or subsequent restoration:


D7: PLS - William Ives, OS, 1850 \* Set quarter section post \* Maple 14, N.10 E., 26 links \* Yellow Birch 14, S.61 W., 27 links \*\*\*\*\* No other subsequent restoration recorded.

B. Description of corner evidence found and/or method applied in restoring or reestablishing corner:

D7: Corner position was established by standard survey methods \* A search was made for GLO corner evidence at and around corner position \* Found Hemlock 16, Northeast of corner position with South face cut flat in 2 areas \* No evidence of blazes or paint, in cardinal directions from corner position \* Reestablished corner position on true line midway between corners East and West \* Corner position falls on East edge of Northerly and Southerly track road \* Corner position is accepted as a careful and faithful reestablishment of the position of the original corner.

C. Description of monument for corner and accessories established to perpetuate locating the position of the corner:

D7: Set a Berntsen Alum. monument no. 41NB30, stamped to identify corner position \* Established reference trees with BT signs, blazed and scribed \* Set PK nails w/Aluz. 1.0 washers for measure in the following - Beech 11, N.37 E., 57.12 feet, not blazed, scribed only, "1/4 BT" \* Maple 14, S.29 W., 11.35 feet, "BT" \* Beech 16, N.41 W., 51.24 feet, not blazed, scribed only, "1/4 BT" \* Maple 17, S.40 E., 35.05 feet, "BT" \* Survey marker sign on 6 foot steel post, S.10 W., 1.35 feet \* All bearings are magnetic.

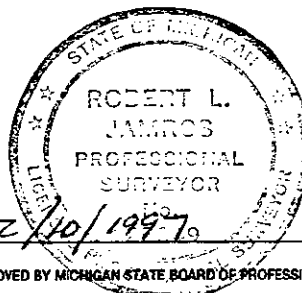

Signed by Robert L. Jamros  
Surveyor's Michigan License No. 25849

Date 12/10/1997