

DEC 27 1999

Approved by Alger County  
Land Survey Remonumentation  
Peer Group Under Act 345 of  
P.A. of 1990 On 12-8-99

Donald W. Kinnunen  
Chairman

05-186

For corners in SECTION

LAND CORNER RECORDATION CERTIFICATE  
Filing Requirement of Act 74, Mich. P.A. 1970

Alger (County)	Located In:	Corner Code #
1. Public Land Survey	T <u>46N</u> R <u>17W</u>	<u>E3</u>
	T _____ R _____	_____
	T _____ R _____	_____
	T _____ R _____	_____
2. Property Controlling in Section	S _____ T _____ R _____	_____
	S _____ T _____ R _____	_____
3. Miscellaneous Property in Section	S _____ T _____ R _____	_____
	S _____ T _____ R _____	_____


FILED  
TIME 1:30 p.m.

DEC 15 1999

DONALD W. KINNUNEN  
REGISTER OF DEEDS  
ALGER COUNTY, MI

Register of Deeds Stamp & File Number

- 4. Lot No. \_\_\_\_\_, Recorded Plat \_\_\_\_\_
- 5. Private Claims \_\_\_\_\_

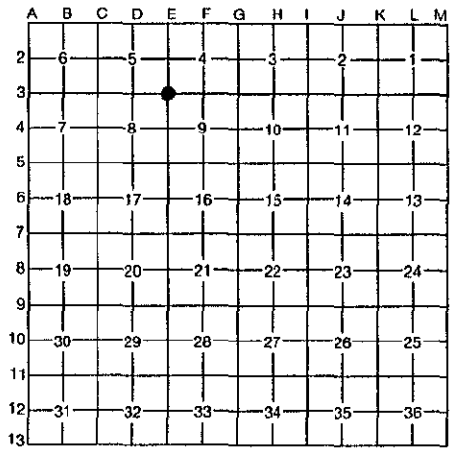

I, Robert L. Jamros, in a field survey on April 28, 1999, 19\_\_\_\_\_, do hereby state that under requirements of P.A. 74, Michigan P.A. of 1970, the corner points mentioned in lines 1 and 2 above were in conformance with regulations and rules therefore as required in the current manual of survey instructions of the United States Department of the Interior, Bureau of Land Management or by a decree of a Court of Law and/or that the corner points mentioned in lines 3, 4 and 5 above were in conformance with the rules of the Michigan Board of Land Surveyors or by a Decree of a Court of Law; established, re-established, monumented, \_\_\_\_\_ recovered, found as expressed below:

NOTE: Not more than 2 corners, all in the same town and range, may be recorded on this certificate.

A. Description of original monument and accessories and/or subsequent restoration:  
 E3: PLS \* William Ives, DS, 1850. \* Set post corner of Sections 4, 5, 8, and 9. \* Sugar 12", S.76 E., 46 links. \* Sugar 20", N.72 W., 37 links. \*\*\*\* George L. Depew, CS, 1915. \* Set iron corner from Government field notes. \* No references given. \*\*\*\* Michigan Department of Conservation, Forestry Division. \* Dean C. DeLaMater, RLS, 1954. \* Found iron pipe with brass cap, set by unknown. \* 10" Elm, S.84 W., 11 links. \* 8" Elm, S.30 W., 12 links. \* Liber 2, Page 55, Alger County Corner Records. \*\*\*\* Michael Mileski, PS, 1997. \* Found 2" iron pipe with 3 1/4" brass cap, dated December 1915. \* 12" S.Maple, N.70 E., 10.35 feet. \* 7" S.Maple, S.13 W., 28.52 feet. \* 15" S.Maple, N.86 W., 27.11 feet. \* 4" S.Maple, N.27 W., 14.92 feet. \* Liber 5, Page 2, Alger County Corner Records. \* No other subsequent restoration of record.

B. Description of corner evidence found and/or method applied in restoring or reestablishing corner:  
 E3: Located corner search area by calculated position and standard field survey methods. Found 2" iron pipe with 3 1/4" brass cap, dated December 1915. \* References of the 1954 report are now only stump holes. Found the 4 references of the 1997 report, standing, alive, and in good condition. Existing corner monument as found is accepted as a careful and faithful perpetuation of the position of the original corner.

C. Description of monument for corner and accessories established to perpetuate locating the position of the corner:  
 E3: Existing 2" iron pipe with 3 1/4" brass cap. \* Renewed existing reference trees with BT signs and paint. \* Set PK nails with aluminum I.D. washers for measure in the following: Existing - Maple 4", N.18 W., 14.75 feet. \* Existing - 12" Maple, N. 78 E., 10.43 feet. \* Existing - Maple 7", S.22 W., 28.60 feet. \* Existing - Maple 15", N.78 W., 27.08 feet. \* Survey marker sign on 6 foot steel post, S.24 E., 1.3 feet. \* All bearings are magnetic.

Signed by Robert L. Jamros  
 Surveyor's Michigan License No. 25649

Date Dec 13, 1999

