

DEC 27 1999

Approved by Alger County
Land Survey Remonumentation
Peer Group Under Act 345 of
P.A. of 1990 On 12-8-1999

Harold Carlson
Chairman

For corners in SECTION LAND CORNER RECORDATION CERTIFICATE
Filing Requirement of Act 74, Mich. P.A. 1970

05-187

Alger (County)	Located In:	Corner Code #
1. Public Land Survey	T <u>46N</u> R <u>17W</u>	<u>E4</u>
	T _____ R _____	_____
	T _____ R _____	_____
	T _____ R _____	_____
2. Property Controlling in Section	S _____ T _____ R _____	_____
	S _____ T _____ R _____	_____
3. Miscellaneous Property in Section	S _____ T _____ R _____	_____
	S _____ T _____ R _____	_____


TIME 1:30 p.m.

DEC 15 1999

DONALD W. KINNUNEN
REGISTER OF DEEDS
ALGER COUNTY, MI

Register of Deeds Stamp & File Number

- 4. Lot No. _____, Recorded Plat _____
- 5. Private Claims _____

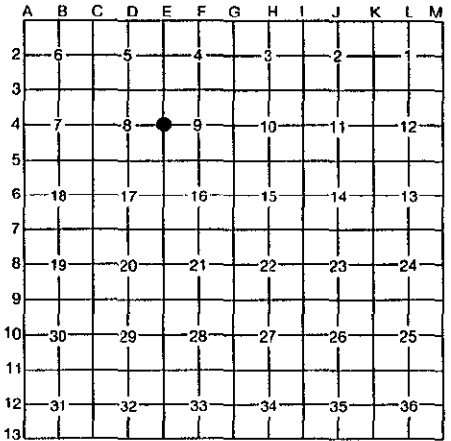

I, Robert L. Jamros, in a field survey on April 27, 1999, 19_____, do hereby state that under requirements of P.A. 74, Michigan P.A. of 1970, the corner points mentioned in lines 1 and 2 above were in conformance with regulations and rules therefore as required in the current manual of survey instructions of the United States Department of the Interior, Bureau of Land Management or by a decree of a Court of Law and/or that the corner points mentioned in lines 3, 4 and 5 above were in conformance with the rules of the Michigan Board of Land Surveyors or by a Decree of a Court of Law; established, re-established, monumented, recovered, found as expressed below:

NOTE: Not more than 2 corners, all in the same town and range, may be recorded on this certificate.

A. Description of original monument and accessories and/or subsequent restoration:

E4: PLS * William Ives, DS, 1850. * Set quarter section post. * Maple 8", S.42 E., 11 links. * Fir 14", N.74 W., 29 links. **** Michigan Department of Conservation, Forestry Division. * Billy D. Buckler, RLS, 1964. * No original evidence found. * The corner was placed midway and on line between section corners. * Set 1" iron pipe with 4" aluminum cap. * 5" S.Maple (1/4s NBT), S.12 E., 19 links. * 5" Y.Birch (1/4s NBT), S.81 W., 04 links. * Liber 2, Page 389, Alger County Corner Records. **** No other subsequent restoration of record.

B. Description of corner evidence found and/or method applied in restoring or reestablishing corner:

E4: Located corner search area by calculated position and standard field survey methods. Found 1" iron pipe with 4" aluminum cap. Also found the 2 references of the 1964 report in good condition. Corner position found to be 0.8 feet east of line and 1.2 feet south of midpoint between section corners 1/2 mile south and 1/2 mile north. Established additional reference trees. Existing corner monument as found is accepted as a careful and faithful reestablishment of the position of the original corner.

C. Description of monument for corner and accessories established to perpetuate locating the position of the corner:

E4: Existing 1" iron pipe with 4" aluminum cap. * Renewed existing reference trees with BT signs and paint. * Established additional reference trees with BT signs, blazed, scribed and painted. * Set PK nails with aluminum I.D. washers for measure in the following: Existing - Y.Birch 7", S.82 W., 2.65 feet. * Existing - Maple 8", S.10 E., 12.95 feet. * Balsam 5", N.25 W., 19.92 feet, "1/4s BT". * Maple 6", N.85 E., 22.95 feet, "1/4s BT. * Survey marker sign on 6 foot steel post, S.30 E., 1.3 feet. * All bearings are magnetic.

Signed by Robert L. Jamros
Surveyor's Michigan License No. 25649

Date Dec 15 1999

