

FEB 19 1998

Approved by Alger County
Land Survey Remonumentation
Peer Group Under Act 345 of
P.A. of 1990 On 12-10-1997

SECTION 05-55

Donald W. Kinnunen
Chairman

LAND CORNER RECORDATION CERTIFICATE
Filing Requirement of Act 74, Mich. P.A. 1970

For corners in	Located in:	Corner Code #
(County)		
1. Public Land Survey	T <u>46</u> R <u>17</u>	<u>E7</u>
	T _____ R _____	_____
	T _____ R _____	_____
	T _____ R _____	_____
2. Property Controlling in Section	S _____ T _____ R _____	_____
	S _____ T _____ R _____	_____
3. Miscellaneous Property in Section	S _____ T _____ R _____	_____
	S _____ T _____ R _____	_____

FILED
TIME 8:30 A.M.

DEC 17 1997


DONALD W. KINNUNEN
REGISTER OF DEEDS
ALGER COUNTY, MI

Register of Deeds Stamp & File Number

4. Lot No. _____, Recorded Plat _____
5. Private Claims _____

I, Robert L. Jamros, in a field survey on October 02, 1997, 19_____, do hereby certify that under requirements of P.A. 74, Michigan P.A. of 1970, the corner points mentioned in lines 1 and 2 above were in conformance with regulations and rules therefore as required in the current manual of survey instructions of the United States Department of the Interior, Bureau of Land Management or by a decree of a Court of Law and/or that the corner points mentioned in lines 3, 4 and 5 above were in conformance with the rules of the Michigan Board of Professional Surveyors or by a Decree of a Court of Law; established, re-established, monumented, re-monumented, recovered, found as expressed below:

NOTE: Not more than 4 corners, all in the same town and range, may be recorded on this certificate.

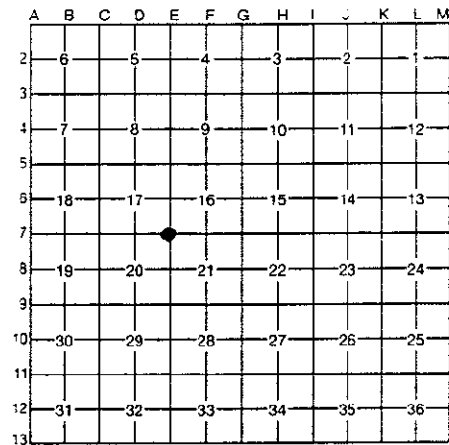

A. Description of original monument and accessories and/or subsequent restoration:

E7: PLS - William Ives, DS, 1850 Post set corner of Sections 16, 17, 20 and 21 * Tamarack 14, N.16 E., 14 links * Cedar 12, S.38 W., 51 links ***** George L. Depew, County Surveyor, 1916 * Set standard iron corner from original field notes * No references given ***** Dean C. DeLaMater, RLS, 1953 * Found 1 1/2 inch pipe w/2 inch brass cap * 1 original BT still in place, excellent condition * Witnesses - Cedar 6, S.83 W., 21 links * Spruce 10, N.65 E., 27 links * Recorded in Liber 2, Page 53, Alger County Corner Records ***** No other subsequent restoration.

B. Description of corner evidence found and/or method applied in restoring or reestablishing corner:

E7: Found Alger County standard monument, 2 inch galv. iron pipe w/3 1/4 brass cap, dated 1916, down and under black muck of swamp bottom * Restored corner position from stump of original Tamarack BT, iron marks and notch visible, and Spruce 10, BT of the 1953 report * Corner position is accepted as a careful and faithful perpetuation of the position of the original corner.

C. Description of monument for corner and accessories established to perpetuate locating the position of the corner:

E7: Exist. Alger County standard monument, stamped to identify corner position * Established references w/BT signs, blazed, scribed and painted * Set PK nails w/Alum. I.D. washers for measure in the following - Cedar 7, S.47 E., 10.92 feet, "S21 BT" * Exist. BT, Spruce 12, N.69 E., 18.37 feet, dbl. blzd. * Balsam 3, S.61 W., 15.78 feet, dbl. blzd., not scribed * Balsam 3, N.18 E., 9.92 feet, dbl. blzd., not scribed * Survey marker on 6 foot steel post, N.89 W., 1.1 feet * All bearings are magnetic.

Signed by Robert L. Jamros
Surveyor's Michigan License No. 25849

Date 12/10/1997

