LAND CORNER RECORDATION CERTIFICATE
Filing Requirement of Act 74, Mich. P.A. 1970

For corners in
Alger
(County)

	Located in:		Corner Code #
1. Public Land Survey		T 46N R 17W	I10
		T___ R___	
		T___ R___	
		T___ R___	
2. Property Controlling	S 26	T 46N R 17W	2
in Section	S___	T___ R___	
3. Miscellaneous	S___	T___ R___	
Property in Sec.	S___	T___ R___	

Register of Deeds Stamp & File Number

4. Lot No. _____ , Recorded Plat _____
5. Private Claims _____

2 Oct 30 2002
I10 Oct 02 2002

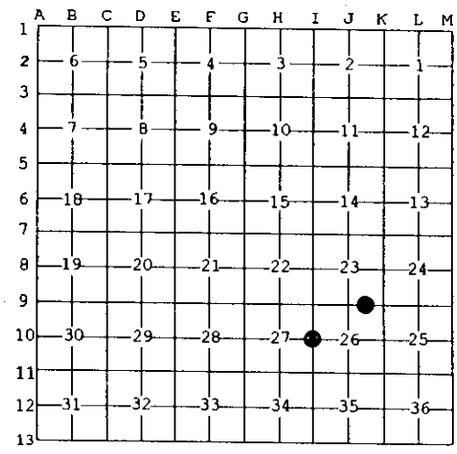

I, Stephan J. Szyszkoski, in a field survey on _____, 19 ____ do hereby state that under requirements of P.A. 74, Michigan P.A. of 1970, the corner points mentioned in lines 1 and 2 above were in conformance with regulations and rules therefore as required in the current manual of survey instructions of the United States Department of the Interior, Bureau of Land Management or by a decree of a Court of Law and /or that the corner points mentioned in lines 3, 4 and 5 above were in conformance with the rules of the Michigan Board of Land Surveyors or by a Decree of a Court of Law; established, re-established, monumented, recovered, found as expressed below:

NOTE: Not more than 2 corners, all in the same town and range, may be recorded on this certificate.

A. Description of original monument and accessories and/or subsequent restoration:

(I10) Quarter corner common to Sections 26-27. 1850: Established by William Ives: South corrected between Sections 26 & 27...39.94 Set Quarter Section post. Cedar 9 N20E 10 links, Spruce 7 S10W 28 links...79.88 Section corner. Found no subsequent record.
(2-Sec. 26) East 1/16 corner between Sections 23-26. Not established in the original survey. Found no subsequent record.

B. Description of corner evidence found and/or method applied in restoring or reestablishing corner:

(I10) The original post and accessories were not recovered. Found no subsequent record. Reestablished the corner midway and on a straight line between Section corners 2634.64' north and south. The corner position falls at the northern edge of a power line clearing.
(2-Sec. 26) Established the corner midway and on a line of mean true bearing between Quarter corner 1320.29' west and Section corner 1320.29' east. A trail road, course East and Northwest, is North, 20' distant.

C. Description of monument for corner and accessories established to perpetuate locating the position of the corner:

(I10) Set 1"IDx36" I.pipe with 4" alum. MDNR cap. Blazed, scribed, and set measuring nails in:
6" twin Cedar N84W 7.2' "1/4S NBT"
5" twin Cedar N04W 3.45' do
5" Spruce N65E 13.8' do
6" Cedar N42W 14.85' do
Bearings are magnetic. Distances are to nail with tag.

(2) Set 1"IDx36" I.pipe with 4" alum. MDNR cap. Blazed, scribed, and set measuring nails in:
18" Maple South 31.2' "E1/16 BT"
8" Cherry S58E 12.05' do
10" Maple N32E 37.7' do
4" Maple N60W 26.05' do
Cedar post adjacent. Bearings are magnetic. Distances are to nail with tag.

STATE OF MICHIGAN
STEPHAN J. SZYSZKOSKI
LAND SURVEYOR
No. 33986
LICENSED LAND SURVEYOR

Signed by Stephan J. Szyszkoski
Surveyor's Michigan License No. 33986

Date 12/5/02

For the Michigan Department of Natural Resources - Office of Property Management

FORM APPROVED BY MICHIGAN STATE BOARD OF PROFESSIONAL SURVEYORS, JAN. 26, 1971
REVISED MAY 14,1975
REVISED JAN., 1983
REVISED OCT., 1995