Approved by Alger County
Land Survey Remonumentation
Peer Group Under Act 345 of
P.A. of 1990 On JUNE 1 1994
Gerald W Carlson
Chairman

LAND CORNER RECORDATION CERTIFICATE

Filing Requirement of Act 74, Mich. P.A. 1970

4-231

For corners in
Alger
(County)

	Located In:	Corner Code ##
1. Public Land Survey	T 46N R 18W	E5
	T ___ R ___	
	T ___ R ___	
	T ___ R ___	
2. Property Controlling	S ___ T ___ R ___	
in Section	S ___ T ___ R ___	
3. Miscellaneous	S ___ T ___ R ___	
Property in Sec.	S ___ T ___ R ___	

Recorded June 24, 1994
at 8:00 o'clock A. M., and
Recorded in Liber 4 of Corner Rec.
on Page 231
Alger County Register of Deeds

Register of Deeds Stamp & File Number

4. Lot No. _____, Recorded Plat _____
5. Private Claims _____

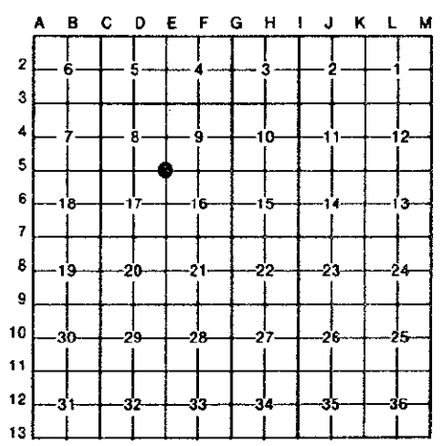

I, Robert L. Jamros, in a field survey on July 31, 1993, 19____, do hereby certify that under requirements of P.A. 74, Michigan P.A. of 1970, the corner points mentioned in lines 1 and 2 above were in conformance with regulations and rules therefore as required in the current manual of survey instructions of the United States Department of the Interior, Bureau of Land Management or by a decree of a Court of Law and/or that the corner points mentioned in lines 3, 4 and 5 above were in conformance with the rules of the Michigan Board of Land Surveyors or by a Decree of a Court of Law; established, re-established, monumented, re-monumented, recovered, found as expressed below:

NOTE: Not more than 4 corners, all in the same town and range, may be recorded on this certificate.

A. Description of original monument and accessories and/or subsequent restoration:

E5: P.L.S., George E. Adair, DS, 1855. Set post at corner of Sections 8, 9, 16 & 17. Y. Birch 24, N.74 W., 26 links. Hemlock 12, S.64 E., 31 links. C.C.I. Co. Forestry Division, on Land & Timber Examination Report as, 4" stake, Y. Birch BT stub and post, 1946 through present. John R. Radcliffe, RLS, 1967, Original Y. Birch BT stumps & scribe marks visible. Set new Cedar post and witnesses,no record filed.

B. Description of corner evidence found and/or method applied in restoring or reestablishing corner:

E5: Found remains of Cedar post and located NBT's at corner position. Found decayed stump remains of original BT, Y. Birch in Northwest position. Installed monument at position established from NBT's and Y. Birch remains. Renewed existing NBT's and established new reference trees and installed Survey Marker sign. Corner lies on easterly edge of ridge in open mixed timber and 50 feet easterly of old railroad grade and is accepted as a careful and faithful perpetuation of the position of the original corner.

C. Description of monument for corner and accessories established to perpetuate locating the position of the corner:

E5: Set 2 1/4" X 30" Alum. Mon. w/3 1/4" Alum. cap stamped to I.D. corner position. Est. reference trees w/BT signs, blazed, scribed and painted. Set PK nails for measuring w/brass I.D. washers in the following reference trees. Ex. - Maple 8", N.37 E., 17.70 feet. Maple 12", S.73 E., 43.08 feet, "S16-BT". Ex. - Maple 20", S.47 W., 1.94 feet. Maple 7", N.31 W., 21.67 feet, "S8-BT". Sur. Marker Sign, N.65 E., 1.0 feet.

Signed by Robert L. Jamros Date 1 June, 1994

Surveyor's Michigan License No. 25849

FORM APPROVED BY MICHIGAN STATE BOARD OF LAND SURVEYORS, JAN. 28, 1971
REVISED MAY 14, 1975
REVISED JAN., 1983