

Approved by Alger County
Land Survey Remonumentation
Peer Group Under Act 345 of
P.A. of 1990 On 12-12-1995

SURVEY &
MONUMENTATION

JAN 23 1996

COMMISSION
4-333

LAND CORNER RECORDATION CERTIFICATE
Filing Requirement of Act 74, Mich. P.A. 1970

For corners in Alger Located In: _____ Corner Code # _____
(County)

- | | | |
|--------------------------------------|--------------------------------------|--|
| 1. Public Land Survey | T <u>46N</u> R <u>18W</u> <u>11</u> | |
| | T <u>47N</u> R <u>18W</u> <u>113</u> | |
| | T _____ R _____ | |
| | T _____ R _____ | |
| 2. Property Controlling in Section | S _____ T _____ R _____ | |
| | S _____ T _____ R _____ | |
| 3. Miscellaneous Property in Section | S _____ T _____ R _____ | |
| | S _____ T _____ R _____ | |

REC'D and FILED

DEC 23 1995
2:45 p.m.
DONALD W. JAMROSE, County Clerk
ALGER COUNTY, MI

Register of Deeds Stamp & File Number

4. Lot No. _____, Recorded Plat _____
5. Private Claims _____

A	B	C	D	E	F	G	H	I	J	K	L
2	6		5		4		3		2		1
3											
4	7		8		9		10		11		12
5											
6	16		17		16		15		14		13
7											
8	19		20		21		22		23		24
9											
10	30		29		28		27		26		25
11											
12	31		32		33		34		35		36
13											

I, Robert L. Jamros, in a field survey on June 08, 1995, 19_____, do hereby certify that under requirements of P.A. 74, Michigan P.A. of 1970, the corner points mentioned in lines 1 and 2 above were in conformance with regulations and rules therefore as required in the current manual of survey instructions of the United States Department of the Interior, Bureau of Land Management or by a decree of a Court of Law and/or that the corner points mentioned in lines 3, 4 and 5 above were in conformance with the rules of the Michigan Board of Professional Surveyors or by a Decree of a Court of Law; established, re-established, monumented, re-monumented, recovered, found as expressed below:

NOTE: Not more than 4 corners, all in the same town and range, may be recorded on this certificate.

A. Description of original monument and accessories and/or subsequent restoration:

I1: PLS-William A. Burt, DS, 1841, Set post corner of sections 2 & 3 - Sugar 22', N.47 E., 40 links, Sugar 10', N.78 W., 17 links. Alger County Road Commission survey note books, Walter W. Gleason, County Surveyor, 1913, Set standard iron corner from original government field notes. No references given. Volume 1, page 49. Corner position shown on MDSH Project Plans No. 02022 and 2-28 for highway M-94. Monument material and witnesses not given. Robert L. Jamros, RLS, 1988, Found 5/8" iron bar in hand hole south of centerline asphalt road. References: Maple 7", N.22 W., 64.1', Balsam Fir, S.13 W., 33.8', P.pole, S.53 E., 40.4'. Filing No. 3-338, Alger County Records.


B. Description of corner evidence found and/or method applied in restoring or reestablishing corner:

I1: Found 5/8 inch iron bar in monument box 0.8 feet south of centerline of H-58 (old M-94) and 16.3 feet west of centerline of road to north. Verified remaining references of 1988 report. Measurements to adjacent corners east and west support corner position. A search was made at GLO bearing tree positions, evidence has been lost to road construction. Corner position is accepted as the best available evidence of the position of the original corner.

C. Description of monument for corner and accessories established to perpetuate locating the position of the corner:

I1: Replaced iron bar w/ 5/8" x 18" rebar w/ Berntsen Cap no. R8D5325 stamped to identify corner position. Established the following reference trees w/ BT signs, blazed, scribed and painted. Set PK nails for measure w/ Alum. I.D. washers in the following reference trees. Maple 8", N.15 W., 88.46 feet, " S34 BT ", P.Pole, S.46 E., 39.29 feet, " scribed BT @ ground level ", Ironwood 7", S.45 W., 57.27 feet, " S3 BT ", Base of 2" Galv. street sign post, N.67 E., 66.52 feet. All bearings are magnetic.

Signed by Robert L. Jamros
Surveyor's Michigan License No. 25849

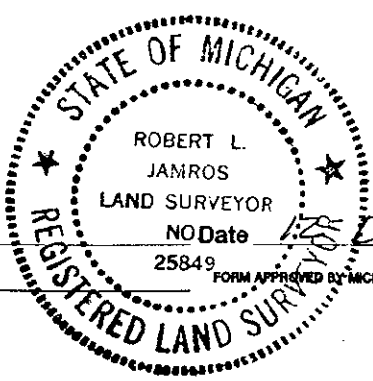

Date 17 December 1995