

Approved by Alger County
Land Survey Monumentation
Peer Group Under Act 345 of
P.A. of 1990 On 12-12-1995

JAN 23 1996

Harold Wilson
Chairman

LAND CORNER RECORDATION CERTIFICATE
Filing Requirement of Act 74, Mich. P.A. 1970

COMMISSION
4-328

For corners in
Alger
(County)

Located In:


Corner Code #

REC'D and FILED

DEC 20 1995
2:45 p.m.
DONALD W. KIMMEL, County Clerk
ALGER COUNTY, MI

Register of Deeds Stamp & File Number

- | | | | |
|--------------------------------------|--------------|--------------|------------|
| 1. Public Land Survey | T <u>46N</u> | R <u>18W</u> | <u>K1</u> |
| | T <u>47N</u> | R <u>18W</u> | <u>K13</u> |
| | T _____ | R _____ | _____ |
| | T _____ | R _____ | _____ |
| 2. Property Controlling in Section | S _____ | T _____ | R _____ |
| | S _____ | T _____ | R _____ |
| 3. Miscellaneous Property in Section | S _____ | T _____ | R _____ |
| | S _____ | T _____ | R _____ |
4. Lot No. _____, Recorded Plat _____
5. Private Claims _____

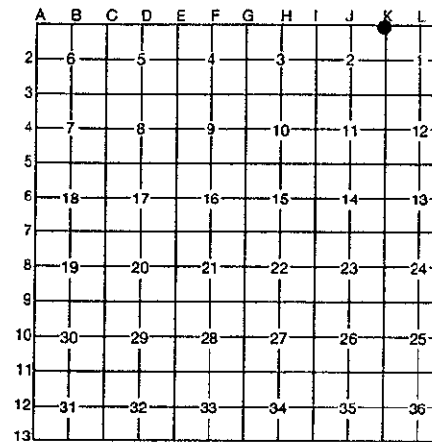

I, Robert L. Jamros, in a field survey on June 07, 1995, 19_____, do hereby certify that under requirements of P.A. 74, Michigan P.A. of 1970, the corner points mentioned in lines 1 and 2 above were in conformance with regulations and rules therefore as required in the current manual of survey instructions of the United States Department of the Interior, Bureau of Land Management or by a decree of a Court of Law and/or that the corner points mentioned in lines 3, 4 and 5 above were in conformance with the rules of the Michigan Board of Professional Surveyors or by a Decree of a Court of Law; established, re-established, monumented, re-monumented, recovered, found as expressed below:

NOTE: Not more than 4 corners, all in the same town and range, may be recorded on this certificate.

A. Description of original monument and accessories and/or subsequent restoration:

K1: PLS-William A. Burt, DS, 1841, Set post corner of sections 1 & 2 - Sugar 20', N.34 E., 17 links, Birch 9', N.49 W., 36 links. Alger County Road Commission survey note books, Walter W. Gleason, County Surveyor, 1913, Set standard iron corner from original government field notes. No references given. Volume 1, pages 50 and 51. Corner position shown on MDSH Project plans No. 02022 and 2-28 for highway M-94. Monument material and witnesses not given. No other subsequent restoration found.

B. Description of corner evidence found and/or method applied in restoring or reestablishing corner:

K1: Found one inch iron bar in monument box 1.8 feet north of the centerline of east-west asphalt road and a two inch galvanized iron pipe w/ 3 1/4 inch brass cap stamped ' 33 feet south to corner ', north of pavement. Measured N.05 E.(magnetic) 33.26 feet from iron bar to brass cap. Author of brass cap unknown. Measurements to corners east and west along highway compare to highway records very well. A search was made at GLO bearing tree positions, evidence is lost. Corner position is accepted as the best available evidence of the position of the original corner.

C. Description of monument for corner and accessories established to perpetuate locating the position of the corner:

K1: Replaced existing one inch iron bar w/ 5/8" x 18" rebar w/ Berntsen Cap no. RBD5325 stamped to identify corner position. Established the following reference trees w/ BT signs, blazed, scribed and painted. Set PK nails for measure w/ Alum. I.D. washers in the following reference trees. Maple 11', N.44 W., 58.09 feet, " S35 BT ", Maple 7', N.41 1/2 E., 51.62 feet, " S36 BT ", Maple 10', S.29 E., 45.86 feet, " S1 BT ", Maple 11', S.35 W., 51.62 feet, " S2 BT ", Two inch G.I.P. w/ brass cap, N.05 E., 33.26 feet, " Wit. Mon." All bearings are magnetic.

Signed by Robert L. Jamros
Surveyor's Michigan License No. 25049

