

Approved by Alger County
Land Survey Remonumentation
Peer Group Under Act 345 of
P.A. of 1990 On 12-12-19 95

Donald W. Carlson
Chairman

LAND CORNER RECORDATION CERTIFICATE
Filing Requirement of Act 74, Mich. P.A. 1970

**SURVEY &
MONUMENTATION**

JAN 23 1996

COMMISSION
4-338

For corners in Alger (County) Located In: _____ Corner Code # _____

- | | | | | | |
|--------------------------------------|---|------------|---|------------|-------|
| 1. Public Land Survey | T | <u>46N</u> | R | <u>18W</u> | K5 |
| | T | _____ | R | _____ | _____ |
| | T | _____ | R | _____ | _____ |
| | T | _____ | R | _____ | _____ |
| 2. Property Controlling in Section | S | _____ | T | _____ | R |
| | S | _____ | T | _____ | R |
| 3. Miscellaneous Property in Section | S | _____ | T | _____ | R |
| | S | _____ | T | _____ | R |

REC'D and FILED

DEC 20 1995

2:45 p.m.

DOUGLAS KANNUNEN, County Clerk
ALGER COUNTY, MI

Register of Deeds Stamp & File Number

4. Lot No. _____, Recorded Plat _____
5. Private Claims _____

I, Robert L. Jamros, in a field survey on June 07, 1995, 19_____, do hereby certify that under requirements of P.A. 74, Michigan P.A. of 1970, the corner points mentioned in lines 1 and 2 above were in conformance with regulations and rules therefore as required in the current manual of survey instructions of the United States Department of the Interior, Bureau of Land Management or by a decree of a Court of Law and/or that the corner points mentioned in lines 3, 4 and 5 above were in conformance with the rules of the Michigan Board of Professional Surveyors or by a Decree of a Court of Law; established, re-established, monumented, re-monumented, recovered, found as expressed below:

| | | | | | | | | | | | |
|----|----|----|----|----|----|----|---|---|---|---|---|
| A | B | C | D | E | F | G | H | I | J | K | L |
| 2 | 6 | 5 | 4 | 3 | 2 | 1 | | | | | |
| 3 | | | | | | | | | | | |
| 4 | 7 | 8 | 9 | 10 | 11 | 12 | | | | | |
| 5 | | | | | | | | | | | |
| 6 | 18 | 17 | 16 | 15 | 14 | 13 | | | | | |
| 7 | | | | | | | | | | | |
| 8 | 19 | 20 | 21 | 22 | 23 | 24 | | | | | |
| 9 | | | | | | | | | | | |
| 10 | 30 | 29 | 28 | 27 | 26 | 25 | | | | | |
| 11 | | | | | | | | | | | |
| 12 | 31 | 32 | 33 | 34 | 35 | 36 | | | | | |
| 13 | | | | | | | | | | | |

NOTE: Not more than 4 corners, all in the same town and range, may be recorded on this certificate.

A. Description of original monument and accessories and/or subsequent restoration:

K5: PLS-George E. Adair, DS, 1855, Set post corner of sections 11,12,13 & 14 - Elm 20', N.64 E., 6 links. Sugar 10', S.63 W., 31 links. No Subsequent Restoration prior to 1988. Robert L. Jamros, RLS, 1988, corner position determined by field survey. No original evidence remaining. Set corner at proportionate distance from line tree stump south and 1/4 section corner to south. Set 1"x 30" iron pipe w/RLS cap. References: Maple 5", N.18 E., 3.25', Maple 12", S.30 E., 20.2', Maple 12", S.37 W., 34.2', Cherry 10", N.65 W., 23.6'. Filing No. 3-340, Alger County Records.


B. Description of corner evidence found and/or method applied in restoring or reestablishing corner:

K5: Found one inch iron pipe with R.L.S. cap. Verified references of 1988 report to be in good condition. Measurements to adjacent corner to east compares very well to GLO records. A search was made at GLO bearing tree positions, no evidence remaining. Corner position is accepted as a careful and faithful reestablishment of the position of the original corner.

C. Description of monument for corner and accessories established to perpetuate locating the position of the corner:

K5: Installed Berntsen Mon. no. A1N830 stamped to identify corner position over existing pipe. Renewed existing reference trees w/ BT signs and paint. Set PK nails for measure w/ Alum. I.D. washers in the following reference trees. Ex. Maple 5", N.31 E., 3.16 feet, " S12 BT ", Ex. Maple 12", S.24 E., 20.27 feet, " S13 BT ", Ex. Cherry 10", N.58 W., 23.36 feet, " S11 BT ", Ex. Maple 12", S.41 W., 34.06 feet, " S14 BT ", Survey Marker sign on six foot steel post, S.37 W., 1.5 feet. All bearings are magnetic.

Signed by Robert L. Jamros
Surveyor's Michigan License No. 25849

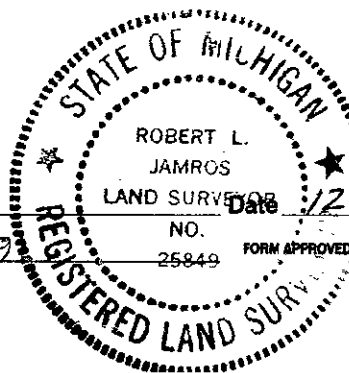

FORM APPROVED BY MICHIGAN STATE BOARD OF PROFESSIONAL SURVEYORS, JAN. 28, 1971
REVISED MAY 14, 1975
REVISED JAN., 1983