

Approved by Alger County
Land Survey Remonumentation
Peer Group Under Act 345 of
P.A. of 1990 On 12-12-1995

Donald W. Carlson
Chairman

LAND CORNER RECORDATION CERTIFICATE
Filing Requirement of Act 74, Mich. P.A. 1970

SURVEY &
MONUMENTATION

JAN 23 1996

COMMISSION
4-337

For corners in Alger Located In: _____ Corner Code # _____
(County)

- | | | | | |
|--------------------------------------|---|-----|------|----|
| 1. Public Land Survey | T | 46N | R18W | K6 |
| | T | | R | |
| | T | | R | |
| | T | | R | |
| 2. Property Controlling in Section | S | | T | R |
| | S | | T | R |
| 3. Miscellaneous Property in Section | S | | T | R |
| | S | | T | R |

REC'D and FILED

JAN 20 1995

2:45 p.m.

DONALD W. CARLSON, County Clerk
ALGER COUNTY, MI

Register of Deeds Stamp & File Number

4. Lot No. _____, Recorded Plat _____
5. Private Claims _____

A	B	C	D	E	F	G	H	I	J	K	L
2	6		5		4		3		2		1
3											
4	7		8		9		10		11		12
5											
6	18		17		16		15		14		13
7											
8	19		20		21		22		23		24
9											
10	30		29		28		27		26		25
11											
12	31		32		33		34		35		36
13											

I, Robert L. Jamros, in a field survey on June 08, 1995, 19_____, do hereby certify that under requirements of P.A. 74, Michigan P.A. of 1970, the corner points mentioned in lines 1 and 2 above were in conformance with regulations and rules therefore as required in the current manual of survey instructions of the United States Department of the Interior, Bureau of Land Management or by a decree of a Court of Law and/or that the corner points mentioned in lines 3, 4 and 5 above were in conformance with the rules of the Michigan Board of Professional Surveyors or by a Decree of a Court of Law; established, re-established, monumented, re-monumented, recovered, found as expressed below:

NOTE: Not more than 4 corners, all in the same town and range, may be recorded on this certificate.

A. Description of original monument and accessories and/or subsequent restoration:

K6: PLS-George E. Adair, DS, 1855, Set Qr. Section Post- Spruce 12", N.16 W., 33 links, Cedar 10", S.84 1/4 E., 8 1/2 links. Robert L. Jamros, RLS, 1988, corner position located by field survey. Found Cedar stump in southeast BT position badly decayed w/ rusty location tag, author unknown. Set corner from cedar stump (S.84 1/4 E., 8 1/2 links). Fits well with section proportions.


B. Description of corner evidence found and/or method applied in restoring or reestablishing corner:

K6: Found one inch iron pipe with R.L.S. cap. Verified remaining references of 1988 report to be in good condition. A search was made at GLO bearing tree positions and remains of decayed cedar were found in the position of S.84 1/4 E., 8 1/2 links. Rusty location tag was not found and believed to be under muck in area. A search was made for other GLO bearing tree, evidence is lost. Corner position is accepted as a careful and faithful perpetuation of the position of the original corner.

C. Description of monument for corner and accessories established to perpetuate locating the position of the corner:

K6: Installed Berntsen Mon. no. A1N830 stamped to identify corner position over existing iron pipe. Renewed existing reference trees w/ BT signs and paint. Established additional reference tree w/ BT signs, blazed, scribed and painted. Set PK nails for measure w/ Alum. I.D. washers in the following reference trees. Ex. Blk. Ash 6", N.21 W., 17.82 feet, " S14 BT ", Ex. Balsam 4", S.63 W., 13.09 feet, " S14 BT ", Ex. Y.Birch 13", S.44 E., 34.66 feet, " S13 BT ", Y.Birch 9", N.69 E., 37.55 feet, " 1/4s BT ", Survey Marker sign on six foot steel post, S.54 E., 1.5 feet. All bearings are magnetic.

Signed by Robert L. Jamros
Surveyor's Michigan License No. 25849

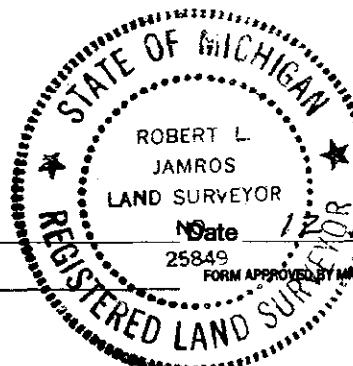

Date 120 December 1995

25849

FORM APPROVED BY MICHIGAN STATE BOARD OF PROFESSIONAL SURVEYORS, JAN. 28, 1971
REVISED MAY 14, 1975
REVISED JAN., 1983