

Approved by Alger County Land Survey Remonumentation Peer Group Under Act 345 of P.A. of 1990 On 12-12-1995

JAN 29 1996

COMMISSION

4-339

Harold Carlson
Chairman

LAND CORNER RECORDATION CERTIFICATE
Filing Requirement of Act 74, Mich. P.A. 1970

For corners in Alger Located in: _____ Corner Code # _____
(County)

- 1. Public Land Survey T 46N R 18W L5 _____
T _____ R _____
T _____ R _____
T _____ R _____
- 2. Property Controlling S _____ T _____ R _____
in Section S _____ T _____ R _____
- 3. Miscellaneous S _____ T _____ R _____
Property in Section S _____ T _____ R _____

REC'D and FILED

DEC 20 1995
2:45 p.m.

DONALD W. KANNUNEN, County Clerk
ALGER COUNTY, MI

Register of Deeds Stamp & File Number

- 4. Lot No. _____, Recorded Plat _____
- 5. Private Claims _____

A	B	C	D	E	F	G	H	I	J	K	L
2	6	5	4	3	2	1					
3											
4	7	8	9	10	11	12					
5											
6	18	17	16	15	14	13					
7											
8	19	20	21	22	23	24					
9											
10	30	29	28	27	26	25					
11											
12	31	32	33	34	35	36					
13											

I, Robert L. Jamros, in a field survey on June 19, 1995, 19____, do hereby certify that under requirements of P.A. 74, Michigan P.A. of 1970, the corner points mentioned in lines 1 and 2 above were in conformance with regulations and rules therefore as required in the current manual of survey instructions of the United States Department of the Interior, Bureau of Land Management or by a decree of a Court of Law and/or that the corner points mentioned in lines 3, 4 and 5 above were in conformance with the rules of the Michigan Board of Professional Surveyors or by a Decree of a Court of Law; established, re-established, monumented, re-monumented, recovered, found as expressed below:

NOTE: Not more than 4 corners, all in the same town and range, may be recorded on this certificate.

A. Description of original monument and accessories and/or subsequent restoration:

L5: PLS-George E. Adair, DS, 1855, Set Qr. Section Post- Beech 9', N.44 E., 24 links, Beech 9', S.76 W., 44 links. No other subsequent restoration found.


B. Description of corner evidence found and/or method applied in restoring or reestablishing corner:

L5: Established corner position by standard survey on line at proportional distance between corners east and west. Paint lines east, west, north and south from corner position and a 16' maple painted temporary corner. No evidence of any corner post or monument. A search was made at GLO bearing tree positions, evidence has been lost. Corner position is accepted as a careful and faithful reestablishment of the position of the original corner.

C. Description of monument for corner and accessories established to perpetuate locating the position of the corner:

L5: Set Berntsen Mon. no. A1N830, stamped to identify corner position. Established the following reference trees w/ BT signs, blazed, scribed and painted. Set PK nails for measure w/ Alum. I.D. washers in the following reference trees. Maple 8', N.67 E., 21.30 feet, 1/4s BT, Maple 12', S.51 W., 17.20 feet, 1/4s BT, Maple 6', S.42 E., 19.1 feet, 1/4s BT, Maple 7', N.30 W., 17.08 feet, 1/4s BT, Survey Marker sign on six foot steel post, S.57 E., 2.0 feet. All bearings are magnetic.

Signed by Robert L. Jamros
Surveyor's Michigan License No. 25849

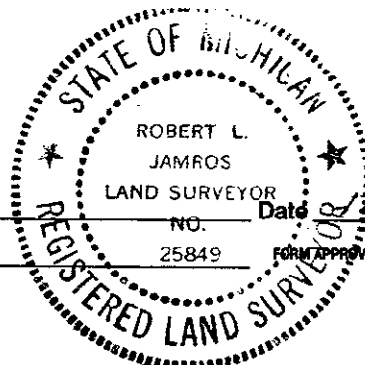

Date 12 December 1995