

**SURVEY &  
REMONUMENTATION**

FEB 19 1998

05-72

Approved by Aiger County  
Land Survey Remonumentation  
Peer Group Under Act 645 of  
P.A. of 1990 On 12-10-1997

Gerald W. Carlson  
Chairman

**SECTION**

**LAND CORNER RECORDATION CERTIFICATE**  
Filing Requirement of Act 74, Mich. P.A. 1970

For corners in _____	Located In:	Corner Code #
(County)		
1. Public Land Survey	T <u>46</u> R <u>17</u>	<u>A2</u>
	T <u>46N</u> R <u>17W</u>	<u>M2</u>
	T _____ R _____	_____
	T _____ R _____	_____
2. Property Controlling in Section	S _____ T _____ R _____	_____
	S _____ T _____ R _____	_____
3. Miscellaneous Property in Section	S _____ T _____ R _____	_____
	S _____ T _____ R _____	_____
4. Lot No. _____, Recorded Plat _____		
5. Private Claims _____		

FILED  
TIME 2:30 A.M.

DEC 17 1997

DONALD W. KINNUNEN  
REGISTER OF DEEDS  
AIGER COUNTY, MI

Register of Deeds Stamp & File Number

I, Robert L. Jamros, in a field survey on November 19, 1997, 19\_\_\_\_\_, do hereby certify that under requirements of P.A. 74, Michigan P.A. of 1970, the corner points mentioned in lines 1 and 2 above were in conformance with regulations and rules therefore as required in the current manual of survey instructions of the United States Department of the Interior, Bureau of Land Management or by a decree of a Court of Law and/or that the corner points mentioned in lines 3, 4 and 5 above were in conformance with the rules of the Michigan Board of Professional Surveyors or by a Decree of a Court of Law; established, re-established, monumented, re-monumented, recovered, found as expressed below:

A	B	C	D	E	F	G	H	I	J	K	L	M
2	6	5	4	3	2	1						
3												
4	7	8	9	10	11	12						
5												
6	18	17	16	15	14	13						
7												
8	19	20	21	22	23	24						
9												
10	30	29	28	27	26	25						
11												
12	31	32	33	34	35	36						
13												

**NOTE: Not more than 4 corners, all in the same town and range, may be recorded on this certificate.**

**A. Description of original monument and accessories and/or subsequent restoration:**


A2: PLS - William A. Burt, SS. 1941 \* Set quarter section post \* Tamarack 10, S.50 W., 17 links \* Spruce 3, N.55 E., 37 links \*\*\*\* J.R. Radcliffe, C.C.I. Co., Forestry Division, 1944 \* Timber cruise sheet indicates stake at corner \*\*\*\* Frank J. Bray, RLS, Michigan Department of Conservation, 1965 \* Set 1 inch iron pipe w/4 inch Alum. cap \* Tamarack 6, N.66 W., 29 links \* Tamarack 8, S.70 E., 51 links \* Corner placed on line at single proportioned distance between section corners \* Report unrecorded \*\*\*\* No other subsequent restoration.

**B. Description of corner evidence found and/or method applied in restoring or reestablishing corner:**

A2: Found 1 inch iron pipe w/4 inch Alum. cap and both BT's of 1965 unrecorded report \* Also found a 2 inch squared cruciform post lying approximately 6 feet Southerly of corner position and a 6 inch scribed, squared post standing at monument \* Corner position lies well at single proportionate distance between corners North and South, and 0.40 feet East of line \* Renewed exist. BT's and established additional reference trees \* Monumented corner position is accepted as a careful and faithful reestablishment of the position of the original corner.

**C. Description of monument for corner and accessories established to perpetuate locating the position of the corner:**

A2: Exist. galv. iron pipe monument w/Alum. cap as stamped to identify corner position \* Renewed exist. BT's w/BT signs and established additional reference trees w/BT signs, blazed and scribed \* Set PK nails for measure w/Alum. I.D. washers in the following - Exist. BT, Tamarack 14, S.53 E., 34.35 feet, upper and lower blazes \* Exist. BT, Tamarack 14, N.61 W., 19.50 feet, upper and lower blazes \* Cedar 16, N.50 E., 45.10 feet, "BT" \* Spruce 6, S.36 W., 19.07 feet, "BT" \* Exist. post, N.70 E., 1.6 feet \* All bearings are magnetic.

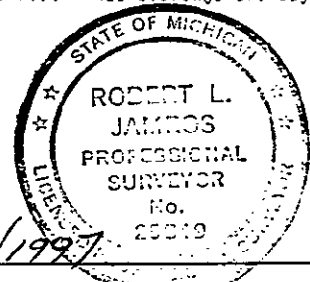

Signed by Robert L. Jamros  
Surveyor's Michigan License No. 25049

Date 12/10/1997