

Approved by Alger County  
Land Survey Commission  
Peer Group Under Act 945 of  
P.A. of 1995 On 12-12-1995

JAN 23 1996

Donald W. Carlson  
Chairman

**LAND CORNER RECORDATION CERTIFICATE**  
Filing Requirement of Act 74, Mich. P.A. 1970

COMMISSION

4-329

For corners in  
Alger  
(County)

Located In:

Corner Code #

- |                                      |              |              |           |
|--------------------------------------|--------------|--------------|-----------|
| 1. Public Land Survey                | T <u>46N</u> | R <u>18W</u> | <u>M5</u> |
|                                      | T <u>46N</u> | R <u>17W</u> | <u>A5</u> |
|                                      | T _____      | R _____      | _____     |
|                                      | T _____      | R _____      | _____     |
| 2. Property Controlling in Section   | S _____      | T _____      | R _____   |
|                                      | S _____      | T _____      | R _____   |
| 3. Miscellaneous Property in Section | S _____      | T _____      | R _____   |
|                                      | S _____      | T _____      | R _____   |

**REC'D and FILED**

DEC 20 1995

2:45 p.m.  
DONALD W. CARLSON, County Clerk  
ALGER COUNTY, MI

Register of Deeds Stamp & File Number

4. Lot No. \_\_\_\_\_, Recorded Plat \_\_\_\_\_  
5. Private Claims \_\_\_\_\_

A	B	C	D	E	F	G	H	I	J	K	L
2	6	5	4	3	2	1					
3											
4	7	8	9	10	11	12					
5											
6	18	17	16	15	14	13					
7											
8	19	20	21	22	23	24					
9											
10	30	29	28	27	26	25					
11											
12	31	32	33	34	35	36					
13											

I, Robert L. Jamros, in a field survey on June 07, 1995, 19\_\_\_\_\_, do hereby certify that under requirements of P.A. 74, Michigan P.A. of 1970, the corner points mentioned in lines 1 and 2 above were in conformance with regulations and rules therefore as required in the current manual of survey instructions of the United States Department of the Interior, Bureau of Land Management or by a decree of a Court of Law and/or that the corner points mentioned in lines 3, 4 and 5 above were in conformance with the rules of the Michigan Board of Professional Surveyors or by a Decree of a Court of Law; established, re-established, monumented, re-monumented, recovered, found as expressed below:

**NOTE: Not more than 4 corners, all in the same town and range, may be recorded on this certificate.**

**A. Description of original monument and accessories and/or subsequent restoration:**

M5: PLS-William A. Burt, DS, 1841, Set post corner of sections 12 & 13 - Sugar 24°, S.71 E., 25 links, Sugar 24°, N.64 W., 52 links. Alger County Road Commission, George L. Depew, County Surveyor, 1917, placed iron corner at section corner. No references given. CCI Forestry Division, Iron pipe shown on map of section twelve, No references given. Author of map unknown.


**B. Description of corner evidence found and/or method applied in restoring or reestablishing corner:**

M5: Found remains of Alger County standard monument, two inch galvanized iron pipe with brass cap missing, in upright position. Corner position lies on centerline of road to south and east. A Search was made at 6LO bearing tree positions, evidence is lost. Corner position is accepted as the best available evidence of the position of the original corner.

**C. Description of monument for corner and accessories established to perpetuate locating the position of the corner:**

M5: Installed 5/8" x 18" rebar w/ Berntsen Cap no. RBD5325 stamped to identify corner position, in centerline of existing two inch pipe. Established the following reference trees w/ BT signs, blazed, scribed and painted. Set PK nails for measure w/ Alum. I.D. washers in the following reference trees. Maple 5", S.42 W., 29.73 feet, " S13 BT ", P.Pole, N.47 W., 35.21 feet, " Scribed BT @ base of pole ", SW Cor. Hse. Conc. Blk. Foundation, N.44 E., 87.50 feet, Maple 5", S.39 E., 129.83 feet, " S18 BT ". All bearings are magnetic.

Signed by Robert L. Jamros  
Surveyor's Michigan License No. 25849

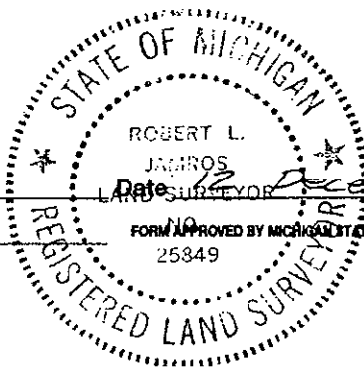

FORM APPROVED BY MICHIGAN STATE BOARD OF PROFESSIONAL SURVEYORS, JAN. 28, 1971  
REVISED MAY 14, 1975  
REVISED JAN., 1983