

Approved by Alger County  
Land Survey Remonumentation  
Peer Group Under Act 345 of  
P.A. of 1990 On 12-12-1995

JAN 29 1996

Harold W. Carlson  
Chairman

**LAND CORNER RECORDATION CERTIFICATE**  
Filing Requirement of Act 74, Mich. P.A. 1970

COMMISSION

For corners in  
Alger  
(County)

Located In:

Corner Code #

4-334

**REC'D and FILED**

- |                                      |                         |           |
|--------------------------------------|-------------------------|-----------|
| 1. Public Land Survey                | T 46N R18W              | <u>M6</u> |
|                                      | T 46N R17W              | <u>A6</u> |
|                                      | T _____ R _____         | _____     |
|                                      | T _____ R _____         | _____     |
| 2. Property Controlling in Section   | S _____ T _____ R _____ | _____     |
|                                      | S _____ T _____ R _____ | _____     |
| 3. Miscellaneous Property in Section | S _____ T _____ R _____ | _____     |
|                                      | S _____ T _____ R _____ | _____     |

DEC 29 1995  
2:45 p.m.

DORIS M. JOHNSON, County Clerk  
ALGER COUNTY, MI

**Register of Deeds Stamp & File Number**

4. Lot No. \_\_\_\_\_, Recorded Plat \_\_\_\_\_  
5. Private Claims \_\_\_\_\_

A	B	C	D	E	F	G	H	I	J	K	L
2	6	5	4	3	2	1					
3											
4	7	8	9	10	11	12					
5											
6	18	17	16	15	14	13					
7											
8	19	20	21	22	23	24					
9											
10	30	29	28	27	26	25					
11											
12	31	32	33	34	35	36					
13											

I, Robert L. Jamros, in a field survey on June 07, 1995, 19\_\_\_\_\_, do hereby certify that under requirements of P.A. 74, Michigan P.A. of 1970, the corner points mentioned in lines 1 and 2 above were in conformance with regulations and rules therefore as required in the current manual of survey instructions of the United States Department of the Interior, Bureau of Land Management or by a decree of a Court of Law and/or that the corner points mentioned in lines 3, 4 and 5 above were in conformance with the rules of the Michigan Board of Professional Surveyors or by a Decree of a Court of Law; established, re-established, monumented, re-monumented, recovered, found as expressed below:

**NOTE: Not more than 4 corners, all in the same town and range, may be recorded on this certificate.**

**A. Description of original monument and accessories and/or subsequent restoration:**

M6: PLS-William A. Burt, DS, 1841, Set Or. Section Post- Beech 6", S.06 E., 18 links, Sugar 9", N.65 W., 32 links. Alger County Road Commission, George L. Depew, County Surveyor, 1916, Placed standard A.C. iron corner at W 1/4 of section 18, T.46N., R.17W. No references given. Robert L. Jamros, RLS, 1981, Found G.I.P. w/brass cap stamped december 1916. Raised to grade with 1/2" rebar. No references established. Robert L. Jamros, RLS, 1992, found 1/2" rebar 3" below pavement of percy road. References: Y.Birch 6", S.42 W., 69.7', Spruce 6", N.56 W., 101.5', Maple 7", S.59 E., 73.4', Maple 6", N.66 E., 52.3'. Filing No. 4-190, Alger County Records.


**B. Description of corner evidence found and/or method applied in restoring or reestablishing corner:**

M6: Found one half inch rebar as installed in the LCRC report of 1981. Position lies 0.3 feet east of centerline of north-south paved road and on centerline of dirt road west. Verified references of the 1992 LCRC report. GLO bearing tree positions have been destroyed by road construction. Corner position is accepted as the best available evidence of the position of the original corner.

**C. Description of monument for corner and accessories established to perpetuate locating the position of the corner:**

M6: Replaced existing 1/2" rebar w/ 5/8" x 14" rebar w/ Berntsen Cap no. RBD5325 stamped to identify corner position. Renewed existing reference trees w/ BT signs and paint. Set PK nails for measure w/ Alum. I.D. washers in the following reference trees. Spruce 8", N.52 W., 101.43 feet, " 1/4s BT ", Y.Birch 7", S.47 W., 69.79 feet, " 1/4s BT ", Maple 7", S.53 E., 73.31 feet, " 1/4s BT ", Maple 7", N.72 E., 52.35 feet. " 1/4s BT ". All bearings are magnetic.

Signed by Robert L. Jamros  
Surveyor's Michigan License No. 25849

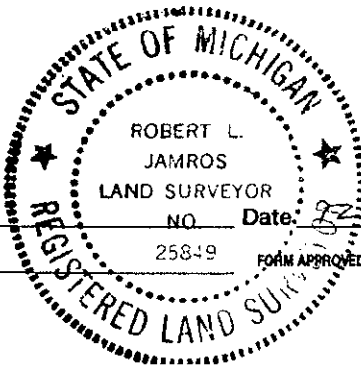

Date: 22 December 1995