

Approved by Alger County
Land Survey Remonumentation
Peer Group Under Act 345 of
P.A. of 1990 On 5/8/1996

Gerald Carlson
Chairman

LAND CORNER RECORDATION CERTIFICATE
Filing Requirement of Act 74, Mich. P.A. 1970

4-389

For corners in Alger (County) Located In: _____ Corner Code # _____

FILED
TIME 3:00 p.m.

- | | | | | | |
|--------------------------------------|---|------------|---|------------|------------|
| 1. Public Land Survey | T | <u>46N</u> | R | <u>18W</u> | <u>M10</u> |
| | T | | R | | |
| | T | <u>46</u> | R | <u>17</u> | <u>A10</u> |
| | T | | R | | |
| 2. Property Controlling in Section | S | | T | | R |
| | S | | T | | R |
| 3. Miscellaneous Property in Section | S | | T | | R |
| | S | | T | | R |

JUN 27 1996

DONALD W. KINNUNEN
REGISTER OF DEEDS
ALGER COUNTY, MI

Register of Deeds Stamp & File Number

4. Lot No. _____, Recorded Plat _____
5. Private Claims _____

	A	B	C	D	E	F	G	H	I	J	K	L
2	6		5		4		3		2		1	
3												
4	7		8		9		10		11		12	
5												
6	18		17		16		15		14		13	
7												
8	19		20		21		22		23		24	
9												
10	30		29		28		27		26		25	
11												
12	31		32		33		34		35		36	
13												

I, Robert L. Jamros, in a field survey on February 08, 1996, 19_____, do hereby certify that under requirements of P.A. 74, Michigan P.A. of 1970, the corner points mentioned in lines 1 and 2 above were in conformance with regulations and rules therefore as required in the current manual of survey instructions of the United States Department of the Interior, Bureau of Land Management or by a decree of a Court of Law and/or that the corner points mentioned in lines 3, 4 and 5 above were in conformance with the rules of the Michigan Board of Professional Surveyors or by a Decree of a Court of Law; established, re-established, monumented, re-monumented, recovered, found as expressed below:

NOTE: Not more than 4 corners, all in the same town and range, may be recorded on this certificate.

A. Description of original monument and accessories and/or subsequent restoration:

M10: PLS-William A. Burt, DS, 1841, Set qr. section post - Birch 14', S.51 E., 33 links, Birch 30', N.22 W., 29 links. No subsequent restoration.***** Alger county Road Commission, 1986-1989, Robert L. Jamros, PS, established corner position at single proportionate measurement between existing corners North and South for road alignment purposes prior to the reconstruction and paving of Percy Road.***** Pete Beaver, PS, 1995, State of Michigan Department of Management and Budget. Verified corner position by survey work for the Department of Corrections. No references made.

B. Description of corner evidence found and/or method applied in restoring or reestablishing corner:

M10: Found 1/2' Rebar with cap no. 25849, 1.2 feet East of the centerline of Percy Road, 6" deep. Corner position verified as being established on line and at single proportionate distance between BT Section corner of Sections 13, 24, 18, and 19, T.46N., R.17-18W., and BT Section corner of Sections 25, 36, 30, and 31, T.46N., R.17-18W. Corner position lies in open graded area around the Casino Correctional Facility and all evidence of original BT's has been destroyed. Corner position is accepted as a careful and faithful reestablishment of the position of the original corner.


SURVEY & REMONUMENTATION

JUL 30 1996

COMMISSION

C. Description of monument for corner and accessories established to perpetuate locating the position of the corner:

M10: Set 5/8"x 18" rebar with Berntsen 3 1/4" aluminum cap no. RBD5325, stamped to identify corner position, along side existing 1/2" rebar, grouted in place with concrete. Established the following references. ** Six foot steel fence post w/ survey marker sign, S.54 E., 43.02 feet, ** Six foot steel fence post w/ survey marker sign, N.50 E., 53.08 feet, ** Six foot steel fence post w/ survey marker sign, N.24 W., 90.29 feet, ** Pole, Electrical Transmission line, S.81 W., 37.60 feet, Scribed BT at base of pole. A PK nail w/ aluminum I.D. washer on side of pole for measure. All bearings are magnetic.

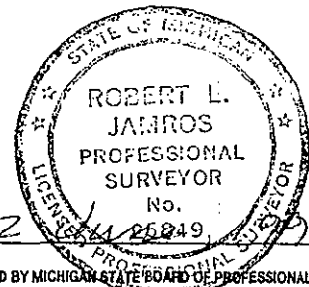

Signed by Robert L. Jamros
Surveyor's Michigan License No. 25849

Date 12 1996