

Approved by Alger County
Land Survey Monumentation
Peer Group Under Act 345 of
P.A. of 1990 On 5/8 1996

Gerald Carlson
Chairman

LAND CORNER RECORDATION CERTIFICATE
Filing Requirement of Act 74, Mich. P.A. 1970

4-390

For corners in
Alger
(County)

Located In:

Corner Code #

FILED
TIME 3:00 p.m.

1. Public Land Survey	T	<u>46N</u>	R	<u>18W</u>	<u>M11</u>
	T		R		
	T	<u>46</u>	R	<u>17</u>	<u>A-11</u>
	T		R		
2. Property Controlling in Section	S		T	R	
	S		T	R	
3. Miscellaneous	S		T	R	
Property in Section	S		T	R	

JUN 27 1996

DONALD W. KINNUNEN
REGISTER OF DEEDS
ALGER COUNTY, MI

Register of Deeds Stamp & File Number

4. Lot No. _____, Recorded Plat _____
5. Private Claims _____

A	B	C	D	E	F	G	H	I	J	K	L
2	6	5	4	3	2	1					
3											
4	7	8	9	10	11	12					
5											
6	18	17	16	15	14	13					
7											
8	19	20	21	22	23	24					
9											
10	30	29	28	27	26	25					
11											
12	31	32	33	34	35	36					
13											

I, Robert L. Jamros, in a field survey on February 08, 1996, 19_____, do hereby certify that under requirements of P.A. 74, Michigan P.A. of 1970, the corner points mentioned in lines 1 and 2 above were in conformance with regulations and rules therefore as required in the current manual of survey instructions of the United States Department of the Interior, Bureau of Land Management or by a decree of a Court of Law and/or that the corner points mentioned in lines 3, 4 and 5 above were in conformance with the rules of the Michigan Board of Professional Surveyors or by a Decree of a Court of Law; established, re-established, monumented, re-monumented, recovered, found as expressed below:

NOTE: Not more than 4 corners, all in the same town and range, may be recorded on this certificate.

A. Description of original monument and accessories and/or subsequent restoration:

M11: PLS-William A. Burt, DS, 1841, Set post corner of sections 25 & 36 - Maple 18", S.25 W., 11 links, Maple 8", N.25 E., 8 links.**** D.S.S.&A. Ry Co., Mackinaw Division, Right of Way and Track Map, June 30, 1916, At Station 5579+66, 88 feet South to corner.**** George L. Depew, CS, October 12, 1916, Set iron corner, BT found. No references made.**** Michigan State Highway Department Right of Way maps, Project 2-17A, 1959-1961, Corner position shown lying South of the survey centerline of Highway M-28 444.60 feet. Corner position noted on plan with a subnote "Not witnessed".

B. Description of corner evidence found and/or method applied in restoring or reestablishing corner:

M11: Found 2" Alger County standard monument with brass cap, stamped and dated October 1916. Also found was a 4" square wooden post with boundary signs, U.S. Forest Service. Verified measurements south from the centerline of railroad tracks and centerline of State Highway M-28. Monument position is accepted as a careful and faithful perpetuation of the position of the original corner.


SURVEY & REMONUMENTATION

JUL 30 1996

COMMISSION

C. Description of monument for corner and accessories established to perpetuate locating the position of the corner:

M11: Stamped P.A. 345 in existing 3 1/4" Brass capped monument. Established reference trees with BT signs, Blazed, scribed and painted. Set PK nails for measure w/Aluminum I.D. washers in the following reference trees. ** Twin 8"-14" Maple, N.54 W., 19.02 feet, "S25 BT", ** W.Pine 6", N.48E., 33.49 feet, "S30 BT", ** Maple 3", S.12 E., 12.65 feet, "S31 BT", ** Maple 3", S.77 W., 3.80 feet, "S36 BT", ** 4" square Cedar post w/ USFS Boundary signs N. and E. faces, North, 1.8 feet, ** Survey marker sign on six foot steel fence post, S.50 E., 2.1 feet, ** All bearings are magnetic.

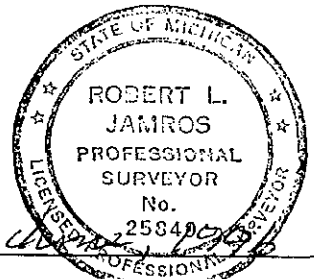

Signed by Robert L. Jamros
Surveyor's Michigan License No. 25849

Date 12/11/96