

Approved by Alger County
 Land Surveyors Association
 For Record at the Office of
 P.A. of 1997 On 3-24-1997

Gerald Carlson
 Chairman

LAND CORNER RECORDATION CERTIFICATE
 Filing Requirement of Act 74, Mich. P.A. 1970

5-20

For corners in Alger Located In: _____ Corner Code # _____
 (County)

1. Public Land Survey T 45N R 21W J1
 T 46N R 21W J13
2. Property Controlling in Section S _____ T _____ R _____
 S _____ T _____ R _____
3. Miscellaneous Property in Section S _____ T _____ R _____
 S _____ T _____ R _____
4. Lot No. _____, Recorded Plat _____
5. Private Claims _____

FILED
 TIME 2:00 p.m.

MAR 31 1997

DONALD W. KINNUNEN
 REGISTER OF DEEDS
 ALGER COUNTY, MI

Register of Deeds Stamp & File Number

T. 46N. R. 21W. J13												
A	B	C	D	E	F	G	H	I	J	K	L	
2	6		5		4		3		2		1	
3												
4	7		8		9		10		11		12	
5												
6	18		17		16		15		14		13	
7												
8	19		20		21		22		23		24	
9												
10	30		29		28		27		26		25	
11												
12	31		32		33		34		35		36	
13												

I, Robert L. Janros, in a field survey on September 18, 1996, 19_____, do hereby certify that under requirements of P.A. 74, Michigan P.A. of 1970, the corner points mentioned in lines 1 and 2 above were in conformance with regulations and rules therefore as required in the current manual of survey instructions of the United States Department of the Interior, Bureau of Land Management or by a decree of a Court of Law and/or that the corner points mentioned in lines 3, 4 and 5 above were in conformance with the rules of the Michigan Board of Professional Surveyors or by a Decree of a Court of Law; established, re-established, monumented, re-monumented, recovered, found as expressed below:

NOTE: Not more than 4 corners, all in the same town and range, may be recorded on this certificate.

A. Description of original monument and accessories and/or subsequent restoration:

J1: P.L.S., John Burt, DS, 1841. * Set qr. Section post. * Sugar 18, N.51 E., 40 links. * Sugar 20, N.62 W., 17 links. **** Corner shown on M.S.H.D. State Trunkline Road Plans at Alger County Road Commission. * Surveyed and Mapped by G. L. Depew, CS, 1919. * No references or monument material shown or given. **** M.S.H.D., 1959 Project, Munising-Chatham Road. * one quarter line shown at highway station 616+16. * No monument documented or shown.

B. Description of corner evidence found and/or method applied in restoring or reestablishing corner:

J1: No existing monument found. Set corner position midway and on line between Sections Corners, East and West. Overall distance between Sections Corners measures 5289.91 feet. Found standing remains of fence line running South from the corner position. Monumented corner position as set and established new references. Corner position lies 2.3 feet North of centerline of M-94 and 2.0 feet West of apparent centerline of "OJA" road. Corner position as set is accepted as a careful and faithful reestablishment of the position of the original corner.

SURVEY & REMONUMENTATION


AUG 15 1997

COMMISSION

C. Description of monument for corner and accessories established to perpetuate locating the position of the corner:

J1: Set 5/8" x 18" Rebar with 3 1/4" Bernstein Aluminum cap no. RBD 5325, stamped to identify corner position. Set PK nails with Aluminum I.D. washers for measure in the following reference objects. * 5' Spruce, S.38 W., 52.43 feet, BT signs, lower blaze scribed "BT", painted. * 4' Spruce, S.13 E., 50.42 feet, BT signs, lower blaze scribed "BT", painted. * P. Pole, N.25 W., 68.05 feet, scribed "BT" at base. * 18' Spruce, N.68 E., 201.01 feet, measuring nail only, tree in residents yard. * All bearings are magnetic.

Signed by Robert L. Janros
 Surveyor's Michigan License No. 25849

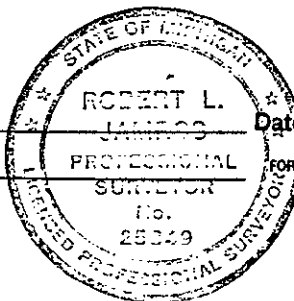

Date 25 March, 1997