

Approved by Alger County
Land Survey Commission
Peer Group of Professional Surveyors of
P.A. of 1909 On 72A-1997

Maude Carlson
Chairman

LAND CORNER RECORDATION CERTIFICATE
Filing Requirement of Act 74, Mich. P.A. 1970


5-05

For corners in ALGER Located in: _____ Corner Code # _____
(County)

- | | | | | | |
|--------------------------------------|---|-----|---|-----|-----|
| 1. Public Land Survey | T | 46N | R | 17W | C1 |
| | T | 47N | R | 17W | C13 |
| | T | | R | | |
| | T | | R | | |
| 2. Property Controlling in Section | S | | T | R | |
| | S | | T | R | |
| 3. Miscellaneous Property in Section | S | | T | R | |
| | S | | T | R | |

FILED
TIME 2:00 pm
MAR 31 1997
DONALD H. KENNEDY
REGISTER OF DEEDS
ALGER COUNTY, MI
Register of Deeds Stamp & File Number

4. Lot No. _____, Recorded Plat _____
5. Private Claims _____

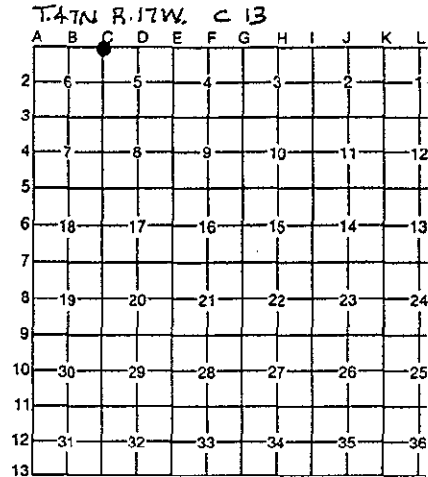

I, Robert L. Jamros, in a field survey on October 31, 1996, 19_____, do hereby certify that under requirements of P.A. 74, Michigan P.A. of 1970, the corner points mentioned in lines 1 and 2 above were in conformance with regulations and rules therefore as required in the current manual of survey instructions of the United States Department of the Interior, Bureau of Land Management or by a decree of a Court of Law and/or that the corner points mentioned in lines 3, 4 and 5 above were in conformance with the rules of the Michigan Board of Professional Surveyors or by a Decree of a Court of Law; established, re-established, monumented, re-monumented, recovered, found as expressed below:

NOTE: Not more than 4 corners, all in the same town and range, may be recorded on this certificate.

A. Description of original monument and accessories and/or subsequent restoration:

C1: William A. Burt, DS, 1841, Set post corner of Sections 31 & 32 * Hemlock 12, N.10 E., 37 links * Hemlock 12, N.55 W., 31 links **** L.E. Adams, CS, 1913. Set standard iron corner from original field notes. **** Edwin Swan, RLS, 1937. * 3/4" iron bolt. * Witness, P. Pole, N 40 E, 29.4 feet. * P. Pole S 18E, 54.2 feet. **** M.S.H.D. Project No. 02022 1958, State Highway M-94 corner position shown at Station 209+30. No ties or monument material shown. **** Robert L. Jamros, RLS, 1984. Found damaged 2" G.I.P. (brass cap missing) at road surface. * Found 3/4" iron bar 0.3 feet South and 1.0 feet below road surface. * Corner is located at approximate P.I. of tangents of Highway curve. * Set 1/2" x 18" rebar in center of existing 2" G.I.P. * References, Birch 9", N.05 E. 47.3 feet to PK w/ washer. * Spruce 12", N.54 E., 49.2 feet to PK w/ washer. * N.W. corner of Tavern Bldg., S.38 E., 110.3 feet. * U.S.G.S. B.M., Brass Cap, S.52 W., 62.3 feet. * Dead Spruce 10", N.30 E., 60.14 feet, Blazed, Scribed "532 N81". * Recorded in L.3, P.349, Alger County Records.

B. Description of corner evidence found and/or method applied in restoring or reestablishing corner:

C1: Found 1/2" Rebar w/ cap #25849 driven into remains of 2" G.I.P. of Alger County Standard Monument on centerlines of asphalt roads East, West and South. Replaced existing monument with new monument and established new references. * Reference objects of 1984 report in poor condition. * Measurements to corners East-West and South check very well within section. * Monument at existing corner position is accepted as a careful and faithful perpetuation of the position of the original corner.

SURVEY & REMONUMENTATION


AUG 15 1997

COMMISSION

C. Description of monument for corner and accessories established to perpetuate locating the position of the corner:

C1: Set 5/8" X 18" Rebar w/ Berntsen 3 1/4" Aluminum cap no. RBD5325, stamped to identify corner position. Established the following reference objects. * W.Birch 8", N.36 1/2 E., 86.58 feet to PK nail w/ aluminum I.D. washer, BT signs, Blazed, Scribed and Painted, "S32". * Southeast corner concrete foundation of garage, #E12498, N.21 W., 58.62 feet. * P.Pole, S.38 W., 87.41 feet to a PK nail w/ aluminum I.D. washer, Scribed "BT" at base. * Northwest corner of main Building of the Bear Trap Inn, S.35 E., 110.12 feet. * All bearings are magnetic.

Signed by Robert L. Jamros
Surveyor's Michigan License No. 25849

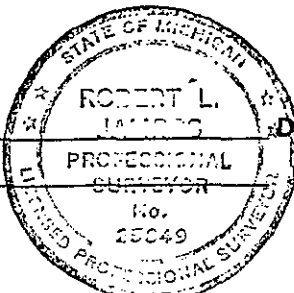

Date 25 March, 1997