

Harold Coulson
 Chairman

LAND CORNER RECORDATION CERTIFICATE
Filing Requirement of Act 74, Mich. P.A. 1970

5-06

For corners in ALGER Located In: _____ Corner Code # _____
 (County)

- | | | | | | | |
|--------------------------------------|---|------------|---|------------|------------|-------|
| 1. Public Land Survey | T | <u>46N</u> | R | <u>17W</u> | <u>01</u> | |
| | T | <u>47N</u> | R | <u>17W</u> | <u>D13</u> | |
| | T | _____ | R | _____ | _____ | |
| | T | _____ | R | _____ | _____ | |
| 2. Property Controlling in Section | S | _____ | T | _____ | R | _____ |
| | S | _____ | T | _____ | R | _____ |
| 3. Miscellaneous Property in Section | S | _____ | T | _____ | R | _____ |
| | S | _____ | T | _____ | R | _____ |
4. Lot No. _____, Recorded Plat _____
 5. Private Claims _____

FILED
 TIME 2:00 pm
 MAR 31 1997
 DONALD W. KENNEDY
 REGISTER OF DEEDS
 ALGER COUNTY, MI
 Register of Deeds Stamp & File Number

	T	<u>47N</u>	R	<u>17W</u>	D13								
A	B	C	D	E	F	G	H	I	J	K	L		
2	6		5		4		3		2		1		
3													
4	7		8		9		10		11		12		
5													
6	18		17		16		15		14		13		
7													
8	19		20		21		22		23		24		
9													
10	30		29		28		27		26		25		
11													
12	31		32		33		34		35		36		
13													

I, Robert L. Jamros, in a field survey on October 31, 1996, 19_____, do hereby certify that under requirements of P.A. 74, Michigan P.A. of 1970, the corner points mentioned in lines 1 and 2 above were in conformance with regulations and rules therefore as required in the current manual of survey instructions of the United States Department of the Interior, Bureau of Land Management or by a decree of a Court of Law and/or that the corner points mentioned in lines 3, 4 and 5 above were in conformance with the rules of the Michigan Board of Professional Surveyors or by a Decree of a Court of Law; established, re-established, monumented, re-monumented, recovered, found as expressed below:

NOTE: Not more than 4 corners, all in the same town and range, may be recorded on this certificate.

A. Description of original monument and accessories and/or subsequent restoration:

D1: PLS - William A. Burt, DS, 1841, Set quarter Section post * Sugar 8, N.77 E., 12 links * Birch 8, N.49 W., 20 links **** Edwin Swan, RLS, 1937, Alger County Road Commission alignment of County Road H-58 from Van Meer to Melstrand. * No corner position shown on plans. **** Robert L. Jamros, 1980. * Found 2" G.I.P. (brass cap missing) 3 1/2' below surface of asphalt road H-58. * Found 2" G.I. with brass cap on North side of road, marked 33 feet South to 1/4S., and 2" G.I.P. with brass cap on South side of road, marked, 33 feet North to 1/4S. * Set 1/2" x 18" rebar with cap at surface of road. * Witness, 12' Maple, N.27 W, 55.25 feet * 6' Maple, S.50 W, 59.90 feet. * Recorded in L.3, P.351, Alger County Records.

B. Description of corner evidence found and/or method applied in restoring or reestablishing corner:

D1: Found 1/2" rebar w/ I.D. cap (damaged) in asphalt pavement 6 feet South of centerline. Evidence of fence row South from corner position. Found 33 feet North of corner position a 2" Galvanized Iron Pipe w/ 3 1/4" Brass cap stamped '33' S. to 1/4S". Also found 3 feet South of corner position a 2" Galvanized Iron Pipe w/ 3 1/4" Brass cap stamped '33' N. to 1/4S". Author unknown. Existing reference trees of 1980 report found in good condition. * Replaced existing monument with new monument and established additional references objects. * Monument at existing corner position as found is accepted as the best available evidence of the position of the original corner.

SURVEY & REMONUMENTATION


AUG 15 1997

COMMISSION

C. Description of monument for corner and accessories established to perpetuate locating the position of the corner:

D1: Replaced existing 1/2" rebar with a 5/8" X 18" Rebar w/ Berntsen 3 1/4" cap no. RBD5325, stamped to identify corner position. Renewed two existing reference trees with BT signs and paint. Added two additional reference trees, BT signs, Blazed, Scribed and Painted. Set PK nails w/ aluminum I.D. washers for measure. * Exist. BT, Maple 8", S.49 W., 59.95 feet to an exist. nail, Face blazed. * Exist. BT, Maple 15", N.22 W., 55.29 feet to an exist. nail, Face blazed. * Maple 12", N.36 E., 68.93 feet, '1/4S BT'. * Maple 8", S.55 E., 70.69 feet, '1/4S'. * All bearings are magnetic.

Signed by Robert L. Jamros
 Surveyor's Michigan License No. 25849

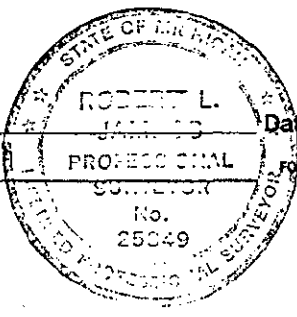

Date 25 March, 1997