

LAND CORNER RECORDATION CERTIFICATE
Filing Requirement of Act 74, Mich. P.A. 1970 as Amended

For corners in

<u>Alger</u> (County)	Located In:	Corner Code #	
1. Public Land Survey	T ___ R ___		
	T ___ R ___		
	T ___ R ___		
	S ___ T ___ R ___		
2. Property Controlling in Section	S 8 T 47N R 17W	9	
	S 8 T 47N R 17W	13	
3. Miscellaneous Property in Sec.	S ___ T ___ R ___		
	S ___ T ___ R ___		
4. Lot No. _____, Recorded Plat _____			
5. Private Claims			

Register of Deeds Stamp & File Number

A	B	C	D	E	F	G	H	I	J	K	L	M
1												
2	6		5		4		3		2		1	
3												
4	7		8		9		10		11		12	
5												
6	18		17		16		15		14		13	
7												
8	19		20		21		22		23		24	
9												
10	30		29		28		27		26		25	
11												
12	31		32		33		34		35		36	
13												

May 19 2004

I, Stephan J. Szyszkoski, in a field survey on _____, 20__ do hereby state that under requirements of P.A. 74, Michigan P.A. of 1970, the corner points mentioned in lines 1 and 2 above were in conformance with regulations and rules therefore as required in the current manual of survey instructions of the United States Department of the Interior, Bureau of Land Management or by a decree of a Court of Law and /or that the corner points mentioned in lines 3, 4 and 5 above were in conformance with the rules of the Michigan Board of Land Surveyors or by a Decree of a Court of Law; established, re-established, monumented, recovered, found as expressed below:

NOTE: Not more than 2 corners, all in the same town and range, may be recorded on this certificate.

A. Description of original monument and accessories and/or subsequent restoration:


- (9-Sec. 8) East 1/16 corner, Section 8. Not established in the original survey.
- (13-Sec. 8) Southeast 1/16 corner, Section 8. Not established in the original survey.

B. Description of corner evidence found and/or method applied in restoring or reestablishing corner:

- (9-Sec. 8) Established the corner midway and on a straight line between Center of Section 1327.45' West and Quarter corner 1327.45' East. The position for the corner falls in the E-W county road, about 4' north of the C/L. From the corner thus established, I found a 1/2" dia. iron bar N 00deg. 13'W (true bearing) 32.67' distant.
- (13-Sec. 8) Established the corner at the intersection of straight lines connecting opposite 1/16 corners.

C. Description of monument for corner and accessories established to perpetuate locating the position of the corner:

- | | |
|---|--|
| (9) Set 5/8" x30" long rebar capped with a yellow plastic cap stamped "MICH DNR PS 33986" 7" below the gravel surface. Blazed, scribed, and set measuring nails in: | (13) Set 1" IDx36" I.pipe with 4" alum. MDNR cap. Blazed, scribed, and set measuring nails in: |
| 10" Maple N33W 42.6' "E1/16 BT" | 10" Balsam S57W 2.45' "SE1/16 BT" |
| 22" Maple N11E 21.7' do | 30" Hemlock S75E 12.45' do |
| 6" Maple N63E 24.9' do | 10" Spruce S39E 17.8' do |
| 5" Maple S23E 32.6' do | 5" Maple N36W 9.4' do |
| Bearings are magnetic. Distances are to nail with tag. | Set cedar post adjacent. Bearings are magnetic. Distances are to nail with tag. |

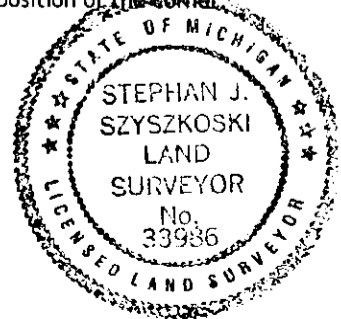

Signed by Stephan J. Szyszkoski
 Surveyor's Michigan License No. 33986

Date 5/5/04

For the Michigan Department of Natural Resources, Office of Land and Facilities