

LAND CORNER RECORDATION CERTIFICATE
Filing Requirement of Act 74, Mich. P.A. 1970 as Amended

For corners in

<u>Alger</u> (County)	Located In:	Corner Code #
1. Public Land Survey	T <u>47N</u> R <u>17W</u>	<u>D4</u>
	T _____ R _____	_____
	T _____ R _____	_____
2. Property Controlling in Section	S _____ T _____ R _____	_____
	S <u>8</u> T <u>47N</u> R <u>17W</u>	<u>14</u>
	S _____ T _____ R _____	_____
3. Miscellaneous Property in Sec.	S _____ T _____ R _____	_____
	S _____ T _____ R _____	_____

4. Lot No. _____, Recorded Plat _____
 5. Private Claims _____

May 19 2004

I, Stephan J. Szyszkoski, in a field survey on _____, 20____ do hereby state that under requirements of P.A. 74, Michigan P.A. of 1970, the corner points mentioned in lines 1 and 2 above were in conformance with regulations and rules therefore as required in the current manual of survey instructions of the United States Department of the Interior, Bureau of Land Management or by a decree of a Court of Law and /or that the corner points mentioned in lines 3, 4 and 5 above were in conformance with the rules of the Michigan Board of Land Surveyors or by a Decree of a Court of Law; established, re-established, monumented, recovered, found as expressed below:

NOTE: Not more than 2 corners, all in the same town and range, may be recorded on this certificate.

A. Description of original monument and accessories and/or subsequent restoration:

(D4) Center of Section 8. Not established in the original survey.
 (14-Sec. 8) South 1/16 corner between Sections 8 and 9. Not established in the original survey.

B. Description of corner evidence found and/or method applied in restoring or reestablishing corner:


(D4) Found a 1/2" rebar, the top section of which is bent over, and the vertical bottom portion of which was found 0.3' from the intersection of straight lines connecting opposite quarter corners. Accepted same as a careful and faithful determination of the position of the corner and replaced it with the monument described below.
 (14-Sec. 8) Established the corner midway and on a straight line between Section corner 1322.52' South and Quarter corner 1322.52' North. From the position thus established I found an iron pipe S 48deg.45'E (true bearing) 3.40' distant which I did not accept as marking the position of the corner.

C. Description of monument for corner and accessories established to perpetuate locating the position of the corner:

(D4) Set 5/8" dia.x30" long rebar with plas. cap "MICH DNR PS 33986" 6" below the gravel road surface. Blazed, scribed, and set measuring nails in:	(14) Set 1"IDx36" I.pipe with 4" alum. MDNR cap. Blazed, scribed, and set measuring nails in:
7" Maple N49E 24.3' CS 8T"	8" Maple S72E 8.05' S1/16 8T"
10" Maple S41E 62.65' do	14" Maple N60E 13.45' do
11" Maple S30W 46.75' do	14" Cherry N18E 20.0' do
10" Maple N01W 36.9' do	20" Maple N61W 4.15' do
Bearings are magnetic. Distances are to nail with tag.	Bearings are magnetic. Distances are to nail with tag.

Register of Deeds Stamp & File Number

A	B	C	D	E	F	G	H	I	J	K	L	M
1												
2	6		5		4		3		2		1	
3												
4	7		●		9		10		11		12	
5				●								
6	18		17		16		15		14		13	
7												
8	19		20		21		22		23		24	
9												
10	30		29		28		27		26		25	
11												
12	31		32		33		34		35		36	
13												

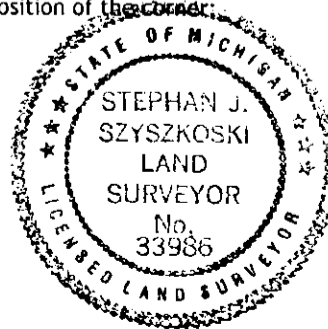

Signed by Stephan J. Szyszkoski
 Surveyor's Michigan License No. 33986

Date 8/5/04

For the Michigan Department of Natural Resources, Office of Land and Facilities