

LAND CORNER RECORDATION CERTIFICATE
Filing Requirement of Act 74, Mich. P.A. 1970 as Amended

For corners in

<u>Alger</u> <small>(County)</small>	Located In:	Corner Code #	
1. Public Land Survey	T <u>47N</u> R <u>17W</u>	<u>E4</u>	
	T <u>47N</u> R <u>17W</u>	<u>E3</u>	
	T _____ R _____	_____	
	S _____ T _____ R _____	_____	
2. Property Controlling in Section	S _____ T _____ R _____	_____	
	S _____ T _____ R _____	_____	
3. Miscellaneous Property in Sec.	S _____ T _____ R _____	_____	
	S _____ T _____ R _____	_____	
4. Lot No. _____, Recorded Plat _____			
5. Private Claims			

Register of Deeds Stamp & File Number

A	B	C	D	E	F	G	H	I	J	K	L	M
1												
2	6		5		4		3		2		1	
3				●								
4	7		8	●	9		10		11		12	
5												
6	18		17		16		15		14		13	
7												
8	19		20		21		22		23		24	
9												
10	30		29		28		27		26		25	
11												
12	31		32		33		34		35		36	
13												

May 19 2004

I, Stephan J. Szyszkoski, in a field survey on _____, 20____ do hereby state that under requirements of P.A. 74, Michigan P.A. of 1970, the corner points mentioned in lines 1 and 2 above were in conformance with regulations and rules therefore as required in the current manual of survey instructions of the United States Department of the Interior, Bureau of Land Management or by a decree of a Court of Law and /or that the corner points mentioned in lines 3, 4 and 5 above were in conformance with the rules of the Michigan Board of Land Surveyors or by a Decree of a Court of Law; established, re-established, monumented, recovered, found as expressed below:

NOTE: Not more than 2 corners, all in the same town and range, may be recorded on this certificate.

A. Description of original monument and accessories and/or subsequent restoration:

(E4) Quarter corner common to Sections 8-9. Reestablished in 1956 by Billy D. Buckler, RLS midway and on line between Section corners. Set 1" iron pipe with 4" brass cap. 15" Hard Maple S54E 30 links, 7" Hard Maple S01W 17 links.
 (E3) Corner common to Sections 4-5-8-9. Reestablished in 1956 by Billy D. Buckler, RLS, by double proportionate measurement. Set 1" pipe with 4" brass cap. 15" W.Spruce S85W 58 links, 10" Balsam N26W 75 links.


B. Description of corner evidence found and/or method applied in restoring or reestablishing corner:

(E4) Recovered the 1956 monument in good condition and at record bearing (with 10 deg. variation applied) and distance from the 1956 BTs, both in good condition with overgrown blazes. I found the monument to be 1.46' from the 1956 midway position of record and accepted the position as a careful and faithful reestablishment of the position of the corner. Left the monument in place and made new witnesses as described below.
 (E3) Found and accepted the 1956 monument, in good condition, and at record bearing and distance from the 1956 witnesses. The W.Spruce is now a rotting stump. The Balsam is standing dead. Left the monument in place and made new witnesses as described below.

C. Description of monument for corner and accessories established to perpetuate locating the position of the corner:

(E4) Found 1" ID 1. pipe with 4" brass cap. Blazed, scribed, and set measuring nails in:	(E3) Found 1" ID 1. pipe with 4" brass cap. Blazed, scribed, and set measuring nails in:
5" Ironwood S75E 7.2' "1/4S NBT"	10" Maple S04W 15.25' "S8 NBT"
6" Sugar N12E 2.15' do	6" Balsam S64W 9.05' do
The 1956 NBTs:	5" twin Maple S08E 9.45' "S9 NBT"
28" Sugar S43E 20.0' "1/4S"	6" Maple S46E 18.85' do
12" Sugar S11W 11.8' do	Bearings are magnetic. Distances are to nail with tag.

Bearings are magnetic. Distances are to nail with tag.

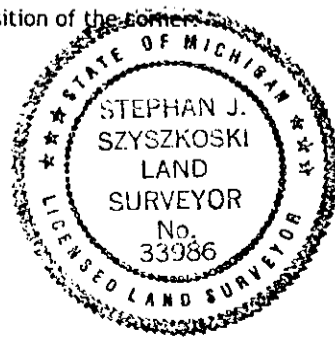

Signed by Stephan J. Szyszkoski
 Surveyor's Michigan License No. 33986

Date 5/15/04

For the Michigan Department of Natural Resources, Office of Land and Facilities