

LAND CORNER RECORDATION CERTIFICATE
Filing Requirement of Act 74, Mich. P.A. 1970 as Amended

For corners in

<u>Alger</u> (County)	Located In:	Corner Code #
1. Public Land Survey	T <u>47N</u> R <u>17W</u>	<u>05</u>
	T <u>47N</u> R <u>17W</u>	<u>05</u>
	T _____ R _____	_____
2. Property Controlling in Section	S _____ T _____ R _____	_____
	S _____ T _____ R _____	_____
3. Miscellaneous Property in Sec.	S _____ T _____ R _____	_____
	S _____ T _____ R _____	_____
4. Lot No. _____, Recorded Plat _____		
5. Private Claims		

Register of Deeds Stamp & File Number

A	B	C	D	E	F	G	H	I	J	K	L	M
1												
2	6		5		4		3		2		1	
3												
4	7		8		9		10		11		12	
5		●	●									
6	18		17		16		15		14		13	
7												
8	19		20		21		22		23		24	
9												
10	30		29		28		27		26		25	
11												
12	31		32		33		34		35		36	
13												

May 19 2004

I, Stephan J. Szyszkoski, in a field survey on _____, 20____ do hereby state that under requirements of P.A. 74, Michigan P.A. of 1970, the corner points mentioned in lines 1 and 2 above were in conformance with regulations and rules therefore as required in the current manual of survey instructions of the United States Department of the Interior, Bureau of Land Management or by a decree of a Court of Law and /or that the corner points mentioned in lines 3, 4 and 5 above were in conformance with the rules of the Michigan Board of Land Surveyors or by a Decree of a Court of Law; established, re-established, monumented, recovered, found as expressed below:

NOTE: Not more than 2 corners, all in the same town and range, may be recorded on this certificate.

A. Description of original monument and accessories and/or subsequent restoration:


(05) Quarter corner common to Sections 8-17. In 1956, Billy D. Buckler RLS found a 2" galvanized iron pipe with brass cap and one Cedar BT in excellent condition. New witnesses: 14" Cedar S31E 16 links, 9" Cedar N44E 13 links.
 (C5) Corner common to Sections 7-8-17-18. Recovered and recorded in 1959 by Billy D. Buckler, RLS. Found 2" I.pipe with brass cap and remains of two H. Maple BTs. Left the monument in place and made new witnesses: 13" H. Maple S30W 22 links, 13" H. Maple N52W 58 links, 13" H. Maple N22E 48 links.

B. Description of corner evidence found and/or method applied in restoring or reestablishing corner:

(05) Found the 1956 monument in good condition and at record bearing and distance from the 1956 witnesses. The Cedar SE has fallen. The Cedar NE is in good condition. Left the monument in place and made new witnesses as described below. The original BT noted in the 1956 record was not recovered.
 (C5) Recovered and accepted the monument noted in the 1959 record, in good condition and at record bearing and distance from the 1959 witnesses, all in good condition with overgrown blazes.

C. Description of monument for corner and accessories established to perpetuate locating the position of the corner:

(05) Found 2" gal. Iron pipe with brass cap. Blazed, scribed, and set measuring nails in:	(C5) Found 2" I.pipe with brass cap. Blazed, scribed, and set measuring nails in:
9" Cedar S80E 10.35' "1/4S NBT"	8" Maple N40W 3.9' "S7 NBT"
9" Cedar N75W 32.05' do	The 1959 NBTs:
8" Cedar N08W 15.1' do	18" Maple N46W 39.6' "S7"
The 1956 witness:	20" Maple N26E 32.5' "S8"
10" Cedar N55E 8.4' no new markings.	21" Maple S30W 14.55' "S17"
Bearings are magnetic. Distances are to nail with tag.	Bearings are magnetic. Distances are to nail with tag.

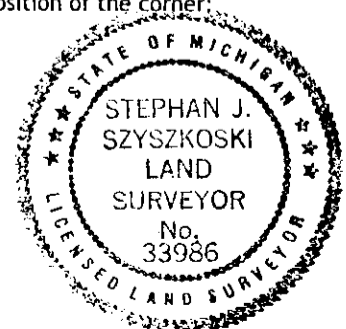

Signed by Stephan J. Szyszkoski
 Surveyor's Michigan License No. 33986

Date 8/5/04

For the Michigan Department of Natural Resources, Office of Land and Facilities