

**LAND CORNER RECORDATION CERTIFICATE**  
**Filing Requirement of Act 74, Mich. P.A. 1970 as Amended**

For corners in

<u>Alger</u> (County)	Located In:	Corner Code #
1. Public Land Survey	T ___ R ___	_____
	T ___ R ___	_____
	T ___ R ___	_____
2. Property Controlling in Section	S ___ T ___ R ___	_____
	S 16 T 47N R 17W	1
	S 16 T 47N R 17W	4
3. Miscellaneous Property in Sec.	S ___ T ___ R ___	_____
	S ___ T ___ R ___	_____

Register of Deeds Stamp & File  
Number

4. Lot No. \_\_\_\_\_, Recorded Plat \_\_\_\_\_  
 5. Private Claims

4 Aug 09 2006  
 1 Aug 08 2006

I, Stephan J. Szyszkoski, in a field survey on \_\_\_\_\_, 20\_\_ do hereby state that under requirements of P.A. 74, Michigan P.A. of 1970, the corner points mentioned in lines 1 and 2 above were in conformance with regulations and rules therefore as required in the current manual of survey instructions of the United States Department of the Interior, Bureau of Land Management or by a decree of a Court of Law and /or that the corner points mentioned in lines 3, 4 and 5 above were in conformance with the rules of the Michigan Board of Land Surveyors or by a Decree of a Court of Law; established, re-established, monumented, recovered, found as expressed below:

A	B	C	D	E	F	G	H	I	J	K	L	M
1												
2	6	5		4		3		2		1		
3												
4	7	8		9		10		11		12		
5												
6	18	17		16		15		14		13		
7												
8	19	20		21		22		23		24		
9												
10	30	29		28		27		26		25		
11												
12	31	32		33		34		35		36		
13												

**NOTE: Not more than 2 corners, all in the same town and range, may be recorded on this certificate.**

A. Description of original monument and accessories and/or subsequent restoration:


- (1-Sec. 16) West 1/16 corner between Sections 9 and 16. Not established in the original survey.
- (4-Sec. 16) Northwest 1/16 corner, Section 16. Not established in the original survey.

B. Description of corner evidence found and/or method applied in restoring or reestablishing corner:

- (1-Sec. 16) Established the corner midway and on the section line between Section corner 1321.09' west and Quarter corner 1321.09' east.
- (4-Sec. 16) Established the corner at the intersection of straight lines connecting opposite 1/16 corners.

C. Description of monument for corner and accessories established to perpetuate locating the position of the corner:

- |   |  |
|---|--|
| (1) Set 1"IDx36" I.pipe with 4" alum.<br>MDNR cap. Set measuring nails in:<br>6" Cedar N14E 12.12' mrkd "N1/16 BT"<br>5" Cedar N61E 8.26' do<br>6" Cedar South 14.2' do<br>10" Spruce S77W 14.5' do<br>Bearings are magnetic. Distances are to nail with tag. | (4) Set 1"IDx36" I.pipe with 4" alum.<br>MDNR cap. Set measuring nails in:<br>11" Cedar N54W 17.28' mrkd "NW1/16 BT"<br>10" Cedar N22E 13.47' do<br>6" Cedar N78E 14.17' do<br>8" Cedar South 17.6' do<br>Bearings are magnetic. Distances are to nail with tag. |
|---|--|

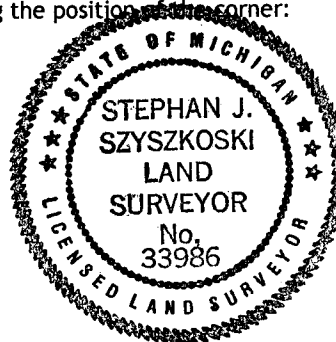

Signed by Stephan J. Szyszkoski  
 Surveyor's Michigan License No. 33986

Date 12/12/06