

Harold Carlson
Chairman

LAND CORNER RECORDATION CERTIFICATE
Filing Requirement of Act 74, Mich. P.A. 1970

5-25

For corners in Alger Located In: Corner Code #
(County)

FILED
TIME 2:00 pm.

MAR 31 1997

DONALD W. KINNUNEN
REGISTER OF DEEDS
ALGER COUNTY, MI

Register of Deeds Stamp & File Number

- Public Land Survey
T 46N R 18W D1
T 47N R 18W D13
T _____ R _____
T _____ R _____
- Property Controlling in Section
S _____ T _____ R _____
S _____ T _____ R _____
- Miscellaneous Property in Section
S _____ T _____ R _____
S _____ T _____ R _____
- Lot No. _____, Recorded Plat _____
- Private Claims _____

T.47N. R.18W. D13

	A	B	C	D	E	F	G	H	I	J	K	L	M
2	6		5		4		3		2		1		
3													
4	7		8		9		10		11		12		
5													
6	18		17		16		15		14		13		
7													
8	19		20		21		22		23		24		
9													
10	30		29		28		27		26		25		
11													
12	31		32		33		34		35		36		
13													

I, Robert L. Jamros, in a field survey on December 10, 1996, 19_____, do hereby certify that under requirements of P.A. 74, Michigan P.A. of 1970, the corner points mentioned in lines 1 and 2 above were in conformance with regulations and rules therefore as required in the current manual of survey instructions of the United States Department of the Interior, Bureau of Land Management or by a decree of a Court of Law and/or that the corner points mentioned in lines 3, 4 and 5 above were in conformance with the rules of the Michigan Board of Professional Surveyors or by a Decree of a Court of Law; established, re-established, monumented, re-monumented, recovered, found as expressed below:

NOTE: Not more than 4 corners, all in the same town and range, may be recorded on this certificate.

A. Description of original monument and accessories and/or subsequent restoration:

D1: PLS-William A. Burt, DS, 1841. Set qr. Section corner. * Beech 9, N.50 E., 13 links. * Sugar 30, N.34 W., 18 links. **** Walter W. Gleason, CS, 1912. * Iron corner set from original field notes. One BT on the ground. **** Alger County Road Commission, Medium sized grey ledger book labeled "Monuments" "Section Corners". This corner is marked as being an iron corner and in place. Ledger believed to be a form of corner inventory prior to 1956. **** Michigan State Highway Department, Project No. 02022, Highway plans for M-94, 1958. * Corner position is shown as a 2" Iron pipe w/ Boal spike in top at highway station 198+99.50. * Corner position is shown as lying 0.96 feet South of survey centerline. * Witness, 14' Maple, S.34 E., 28.16 feet. * 8' Maple, S.06 W., 24.88 feet. * T.Pole, N.54 W., 63.60 feet. **** Robert L. Jamros, RLS, 1978. Found 3/4" bar in monument box at centerline of asphalt pavement County Highway H-58 (old M-94) and line fence to the South. * Witness, Maple 10", N.30 W., 58.72 feet. * Y. Birch 13", S.15 E., 38.70 feet. * Ash 8", S.40 W., 59.50 feet. * Recorded in L.1, P.183, Alger County Records.


B. Description of corner evidence found and/or method applied in restoring or reestablishing corner:

D1: Found 3/4" iron bar in monument box without cover on centerline of pavement of County Highway H-58 (old M-94). * Also found one remaining reference tree from the 1978 report. * Reference objects as shown on the Michigan State Highway Department 1958 Project Plans for M-94 (presently H-58) have either been destroyed or removed. * The difference between the highway stations of this corner and the Section corner to the East is 2632.79 feet, as measured for this report, 2632.44 feet. * Monument as found is accepted as the best available evidence of the position of the original corner.

C. Description of monument for corner and accessories established to perpetuate locating the position of the corner:

D1: Replaced 3/4" iron bar with 5/8" X 18" Rebar with Berntsen 3 1/4" aluminum cap no. RBD5325, stamped to identify corner position. * Renewed existing reference tree and added two additional reference trees, blazed, scribed and painted. * No other reference available. * Set PK nails for measure w/ aluminum I.D. washers in the following reference trees. * Maple 11", S.52 W., 65.57 feet, "BT". * Maple 15", S.03 E., 40.95 feet, "BT". * Exist. BT, Maple 15", N.24 W., 58.63 feet, "BT". * All bearings are magnetic.

Signed by Robert L. Jamros
Surveyor's Michigan License No. 25849

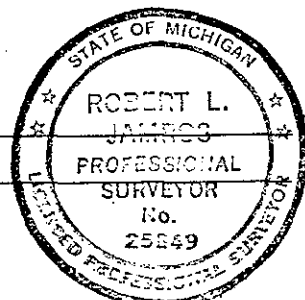

Date 25 March, 1997