

# SURVEY & REMONUMENTATION

Approved by Alger County  
Land Survey Remonumentation  
Peer Group Under Act 345 of  
P.A. of 1990 On 5/8/1996

JUL 30 1996

## LAND CORNER RECORDATION CERTIFICATE Filing Requirement of Act 74, Mich. P.A. 1970

4-385

Gerald W. Carlson  
Chairman

For corners in \_\_\_\_\_ Located In: \_\_\_\_\_ Corner Code # \_\_\_\_\_  
Alger (County)

**FILED**  
TIME 3:00 p.m.

- |                                      |   |           |   |           |             |
|--------------------------------------|---|-----------|---|-----------|-------------|
| 1. Public Land Survey                | T | 46N       | R | 18W       | F1          |
|                                      | T |           | R |           |             |
|                                      | T | <u>47</u> | R | <u>18</u> | <u>F-13</u> |
|                                      | T |           | R |           |             |
| 2. Property Controlling in Section   | S |           | T | R         |             |
|                                      | S |           | T | R         |             |
| 3. Miscellaneous Property in Section | S |           | T | R         |             |
|                                      | S |           | T | R         |             |

JUN 27 1996

DONALD W. KINNUNEN  
REGISTER OF DEEDS  
ALGER COUNTY, MI

Register of Deeds Stamp & File Number

4. Lot No. \_\_\_\_\_, Recorded Plat \_\_\_\_\_  
5. Private Claims \_\_\_\_\_

	A	B	C	D	E	F	G	H	I	J	K	L
2	6		5		4		3		2		1	
3												
4	7		8		9		10		11		12	
5												
6	18		17		16		15		14		13	
7												
8	19		20		21		22		23		24	
9												
10	30		29		28		27		26		25	
11												
12	31		32		33		34		35		36	

I, Robert L. Jamros, in a field survey on February 09, 1996, 19\_\_\_\_\_, do hereby certify that under requirements of P.A. 74, Michigan P.A. of 1970, the corner points mentioned in lines 1 and 2 above were in conformance with regulations and rules therefore as required in the current manual of survey instructions of the United States Department of the Interior, Bureau of Land Management or by a decree of a Court of Law and/or that the corner points mentioned in lines 3, 4 and 5 above were in conformance with the rules of the Michigan Board of Professional Surveyors or by a Decree of a Court of Law; established, re-established, monumented, re-monumented, recovered, found as expressed below:

**NOTE: Not more than 4 corners, all in the same town and range, may be recorded on this certificate.**

**A. Description of original monument and accessories and/or subsequent restoration:**


F1: PLS-William A. Burt, DS, 1841, Set qr. section post - Sugar 12', N.11 E., 45 links, Sugar 24', N.69 W., 9 links.\*\*\*\* Walter W. Gleason, Deputy CS, 1912, Iron corner set at the center of the straight line between section corners East and West. Lines run by Transit.\*\*\*\* Alger County Road Commission, George Depew, County Surveyor, 1915, Corner shown on road plans for the Grand Marais-Munising road as brass cap iron. No references given.\*\*\*\* Michigan State Highway Department, Project No. 02022, 1958, Highway plans for M-94, Corner position not shown on plans relative to centerline or survey centerline.\*\*\*\* Herbert L. Fluharty, RLS, 1977, Set 5/8" x 18' re-rod w/ RLS cap, equal distance and on line in centerline of blacktop road. Established the following references, P.Pole, S.65 E., 78.20 feet, P.Pole, N.33 E., 32.65 feet, Steel mail box post, S.28 W., 20.49 feet. Filing No. 89, Alger County Records.

**B. Description of corner evidence found and/or method applied in restoring or reestablishing corner:**

F1: Found 5/8" Rebar, cap missing, on centerline of existing asphalt road, County Hwy. H-58 East (old M-94). References of the 1977 report have been lost. Measurements to section corners East and West support the the method of reestablishment stated in the report of 1977. Old line fence bears North at East 1/16 corner position along this line. Monument position is accepted as a careful and faithful reestablishment of the position of the original corner.

**C. Description of monument for corner and accessories established to perpetuate locating the position of the corner:**

F1: Set Heratsen 3 1/4' aluminum cap, stamped to identify corner position, on existing 5/8" rebar and grouted in place with concrete. Established the following references. Steel fence post with 911 sign no. E10675, S.62 W., 69.65 feet.\*\* P.Pole scribed BT at base, S.61 E., 76.66 feet.\*\* Six foot steel fence post w/ survey marker sign, N.33 W., 60.03 feet.\*\* Six foot steel fence post w/ survey marker sign, N.38 E., 53.82 feet. All bearings are magnetic.

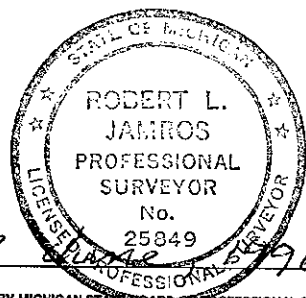

Signed by Robert L. Jamros  
Surveyor's Michigan License No. 25849

Date 12 1996