

JAN 28 1996

COMMISSION
4-336

Approved by Alger County
Land Survey Remonumentation
Peer Group Under Act 345 of
P.A. of 1990 On 12-12-19 95

Donald W. Carlson
Chairman

LAND CORNER RECORDATION CERTIFICATE
Filing Requirement of Act 74, Mich. P.A. 1970

For corners in Alger Located in: _____ Corner Code # _____
(County)

- 1. Public Land Survey T 46N R 18W G1
T 47N R 18W G13
T _____ R _____
T _____ R _____
- 2. Property Controlling S _____ T _____ R _____
in Section S _____ T _____ R _____
- 3. Miscellaneous S _____ T _____ R _____
Property in Section S _____ T _____ R _____
- 4. Lot No. _____, Recorded Plat _____
- 5. Private Claims _____

REC'D and FILED

DEC 29 1995
2:45 p.m.
DONALD W. CARLSON, County Clerk
ALGER COUNTY, MI

Register of Deeds Stamp & File Number

A	B	C	D	E	F	G	H	I	J	K	L
2	6	5	4	3	2	1					
3											
4	7	6	5	4	3	2	1				
5											
6	18	17	16	15	14	13					
7											
8	19	20	21	22	23	24					
9											
10	30	29	28	27	26	25					
11											
12	31	32	33	34	35	36					
13											

I, Robert L. Jamros, in a field survey on June 08, 1995, 19_____, do hereby certify that under requirements of P.A. 74, Michigan P.A. of 1970, the corner points mentioned in lines 1 and 2 above were in conformance with regulations and rules therefore as required in the current manual of survey instructions of the United States Department of the Interior, Bureau of Land Management or by a decree of a Court of Law and/or that the corner points mentioned in lines 3, 4 and 5 above were in conformance with the rules of the Michigan Board of Professional Surveyors or by a Decree of a Court of Law; established, re-established, monumented, re-monumented, recovered, found as expressed below:

NOTE: Not more than 4 corners, all in the same town and range, may be recorded on this certificate.

A. Description of original monument and accessories and/or subsequent restoration:

G1: PLS-William A. Burt, DS, 1841, Set post corner of sections 3 & 4 - Sugar 9°, N.31 E., 42 links, Sugar 14°, N.66 W., 18 links. Corner position shown on MDSH Project plans No. 02022 and 2-28 for highway M-94. Monument material and witnesses not given. Herbert L. Fluharty, RLS, 1977, Found 3/4" iron in monument box in centerline of black top road. References: Twin Elm 17°, N.47 W., 48.53', Elm cluster 16°, S.55 E., 87.40', P.pole, S.02 E., 31.64'. Filing No. 89, Alger County Records.


B. Description of corner evidence found and/or method applied in restoring or reestablishing corner:

G1: Found ancient 3/4 inch iron bar in monument box on centerline of east-west highway and 1.5 feet east of centerline of highway to the north. Measurements to corners along highways north, west and east compare to highway records very well. A search was made at GLO bearing tree positions, evidence is lost. Corner position is accepted as the best available evidence of the position of the original corner.

C. Description of monument for corner and accessories established to perpetuate locating the position of the corner:

G1: Replaced iron bar w/ 5/8" x 18' rebar w/ Berntsen Cap no. RBD5325 stamped to identify corner position. Established the following reference trees w/ BT signs, blazed, scribed and painted. Set PK nails for measure w/Alum. I.D. washers in the following reference trees. Westerly sign post, S.22 W., 48.26 feet, " scribed BT @ ground level ", Maple 8°, S.64 E., 128.46 feet, " S3 BT ", P.Pole, N.13 W., 176.0 feet, " scribed BT @ ground level ", Spruce 9°, N.18 W., 98.41 feet, " S33 BT ". All bearings are magnetic.

Signed by Robert L. Jamros
Surveyor's Michigan License No. 25849

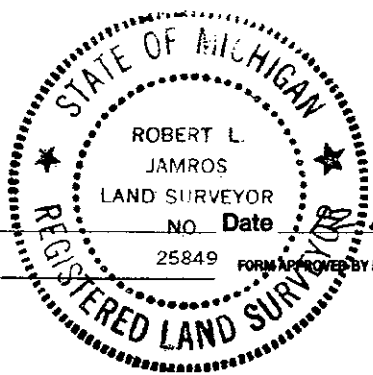

Date 22 December 1995