

Approved by Alger County
Land Survey Remonumentation
Peer Group Under Act 345 of
P.A. of 1990 On 12-12-1995

Gerald W. Carlson
Chairman

For corners in

Alger (County)

Located In:

Corner Code #

LAND CORNER RECORDATION CERTIFICATE
Filing Requirement of Act 74, Mich. P.A. 1970

JAN 23 1996

4 CORRECTION

REC'D and FILED

DEC 20 1995

2:45 p.m.

DONALD W. KENNEDY, County Clerk
ALGER COUNTY, MI

Register of Deeds Stamp & File Number

- | | | |
|--------------------------------------|---------------------------|------------|
| 1. Public Land Survey | T <u>46N</u> R <u>18W</u> | H1 |
| | T <u>47N</u> R <u>18W</u> | <u>H13</u> |
| | T _____ R _____ | _____ |
| | T _____ R _____ | _____ |
| 2. Property Controlling in Section | S _____ T _____ R _____ | _____ |
| | S _____ T _____ R _____ | _____ |
| 3. Miscellaneous Property in Section | S _____ T _____ R _____ | _____ |
| | S _____ T _____ R _____ | _____ |
4. Lot No. _____, Recorded Plat _____
5. Private Claims _____

	A	B	C	D	E	F	G	H	I	J	K	L
2	6	5	4	3	2	1						
3												
4	7	8	9	10	11	12						
5												
6	18	17	16	15	14	13						
7												
8	19	20	21	22	23	24						
9												
10	30	29	28	27	26	25						
11												
12	31	32	33	34	35	36						
13												

I, Robert L. Jamros, in a field survey on August 31, 1995, 19_____, do hereby certify that under requirements of P.A. 74, Michigan P.A. of 1970, the corner points mentioned in lines 1 and 2 above were in conformance with regulations and rules therefore as required in the current manual of survey instructions of the United States Department of the Interior, Bureau of Land Management or by a decree of a Court of Law and/or that the corner points mentioned in lines 3, 4 and 5 above were in conformance with the rules of the Michigan Board of Professional Surveyors or by a Decree of a Court of Law; established, re-established, monumented, re-monumented, recovered, found as expressed below:

NOTE: Not more than 4 corners, all in the same town and range, may be recorded on this certificate.

A. Description of original monument and accessories and/or subsequent restoration:

H1: PLS-William A. Burt, DS, 1841, Set Or. Section Post- Sugar 18", N.39 E., 22 links, Sugar 6", N.37 W., 37 links. Walter W. Gleason, County Surveyor, 1913, Set standard iron corner on straight line and halfway between section corners. No references given. Record book of surveys, page 122. Alger County Records. Corner position shown on MDSH Project plans No. 02022 and 2-28 for highway M-94. Monument material and witnesses not given. CCI Forestry Division, Land and Timber Examination Report, R. Radcliffe, RLS, 1950, Notes on timber cruise sheet iron corner at corner position. No references given.

B. Description of corner evidence found and/or method applied in restoring or reestablishing corner:

H1: Found 2 1/4 inch galvanized iron pipe with 3 1/4 inch brass cap, no markings, north of east-west paved road and 2 1/4 inch galvanized iron pipe w/ slanted brass plate marked " 33 feet N. to 1/4s ", south of east-west paved road, author unknown. Measurements between monuments is 66.22 feet. Established corner position on line between monuments and 33 feet north of monument with slanted plate. Measurements to corners east and west along highway compare to highway records very well. A search was made with a locator for a iron monument under highway with no results. A search was made at GLO bearing tree positions, evidence is lost. Corner position is accepted as a careful and faithful reestablishment of the position of the original corner.

C. Description of monument for corner and accessories established to perpetuate locating the position of the corner:


H1: Set 5/8" x 18" rebar w/ Berntsen Cap no. R805325 stamped to identify corner position. Established the following reference trees w/ BT signs, blazed, scribed and painted. Set PK nails for measure w/ Alum. I.D. washers in the following reference trees. Maple 8", N.51 E., 46.58 feet, " 1/4s BT ", Twin Maple 6" & 8", N.37 W., 64.95 feet, " 1/4s BT ", Spruce 7", S.27 W., 45.98 feet, " 1/4s BT ", Maple 5", S.22 E., 57.36 feet, " 1/4s BT ". All bearings are magnetic.

Signed by

Robert L. Jamros

Surveyor's Michigan License No.

25849

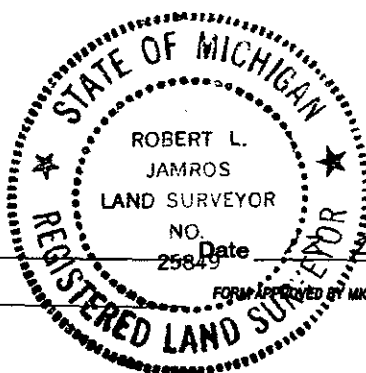

Date

December 1995