

Approved by Alger County Land Survey Remonumentation Peer Group Under Act 345 of P.A. of 1990 On 12-12-19 95

JAN 23 1996

Gerald W. Carlson
Chairman

LAND CORNER RECORDATION CERTIFICATE
Filing Requirement of Act 74, Mich. P.A. 1970

COMMISSION
4-332

For corners in Alger Located In: Corner Code #
(County)

- 1. Public Land Survey T 46N R 18W T 11
T 47N R 18W T 113
- 2. Property Controlling in Section S ___ T ___ R ___
S ___ T ___ R ___
- 3. Miscellaneous Property in Section S ___ T ___ R ___
S ___ T ___ R ___

REC'D and FILED

DEC 20 1995
2:45 p.m.

DONALD W. KINNUNEN, County Clerk
ALGER COUNTY, MI

Register of Deeds Stamp & File Number

- 4. Lot No. _____, Recorded Plat _____
- 5. Private Claims _____

	A	B	C	D	E	F	G	H	I	J	K	L
2	6		5		4		3		2		1	
3												
4	7		8		9		10		11		12	
5												
6	18		17		16		15		14		13	
7												
8	19		20		21		22		23		24	
9												
10	30		29		28		27		26		25	
11												
12	31		32		33		34		35		36	
13												

I, Robert L. Jamros, in a field survey on September 08, 1995, 19____, do hereby certify that under requirements of P.A. 74, Michigan P.A. of 1970, the corner points mentioned in lines 1 and 2 above were in conformance with regulations and rules therefore as required in the current manual of survey instructions of the United States Department of the Interior, Bureau of Land Management or by a decree of a Court of Law and/or that the corner points mentioned in lines 3, 4 and 5 above were in conformance with the rules of the Michigan Board of Professional Surveyors or by a Decree of a Court of Law; established, re-established, monumented, re-monumented, recovered, found as expressed below:

NOTE: Not more than 4 corners, all in the same town and range, may be recorded on this certificate.

A. Description of original monument and accessories and/or subsequent restoration:

J1: PLS-William A. Burt, OS, 1841, Sugar 5' qr.section corner - Sugar 12", N.33 W., 36 links. Alger County Road Commission survey note books, Walter W. Gleason, County Surveyor, 1913, Set standard iron corner from original government field notes. No references given. Volume 1, page 50 and 51. Corner position shown on MDSH Project plans No. 02022 and 2-28 for highway M-94. Monument material and witnesses not given. CCI Forestry Division, Land and Timber Examination Report, R. Radcliffe, RLS, 1950, Notes on timber cruise map an iron corner at corner position. No references given.


B. Description of corner evidence found and/or method applied in restoring or reestablishing corner:

J1: Found 2 inch galvanized iron pipe with 3 1/4 inch brass cap marked " 1/4s 33 feet south", Author unknown, north of east-west paved highway. A search was made with locator for a iron monument under highway with no results. Established corner position 33 feet south of brass capped monument. Measurements to corners east and west along highway compare to highway records very well. A search was also made at GLO bearing tree positions, evidence is lost. Corner position is accepted as a careful and faithful reestablishment of the position of the original corner.

C. Description of monument for corner and accessories established to perpetuate locating the position of the corner:

J1: Set 5/8" x 18" rebar w/ Berntsen Cap no. RBD5325 stamped to identify corner position. Established the following reference trees w/ BT signs, blazed, scribed and painted. Set PK nails for measure w/ Alum. I.D. washers in the following reference trees. Maple 10", N.36 W., 54.00 feet, " 1/4s BT ", Maple 5", N.28 E., 49.48 feet, " 1/4s BT ", Two inch G.I.P. w/ brass cap, N.04 E., 33.0 feet, " Wit. Mon. ", Maple 8", S.52 E., 80.86 feet, " 1/4s BT ". All bearings are magnetic.

Signed by Robert L. Jamros
Surveyor's Michigan License No. 25849

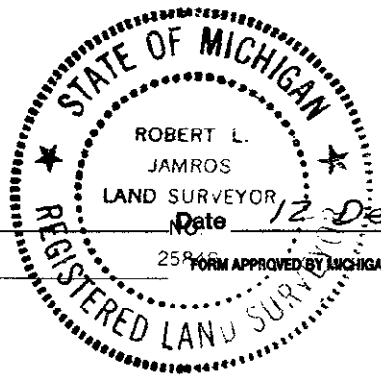

Date 12 December 1995