

Approved by Alger County
Land Survey Remonumentation
Peer Group Under Act 345 of
P.A. of 1990 On 12-12-1995

Arnold W. Carlson
Chairman

LAND CORNER RECORDATION CERTIFICATE
Filing Requirement of Act 74, Mich. P.A. 1970

SURVEY &
REMONUMENTATION

JAN 23 1996

4-335
COMMISSION

For corners in Alger Located In: _____ Corner Code # _____
(County)

- | | | |
|--------------------------------------|---------------------------|------------|
| 1. Public Land Survey | T <u>46N</u> R <u>18W</u> | L1 |
| | T <u>47N</u> R <u>18W</u> | <u>L13</u> |
| | T _____ R _____ | _____ |
| | T _____ R _____ | _____ |
| 2. Property Controlling in Section | S _____ T _____ R _____ | _____ |
| | S _____ T _____ R _____ | _____ |
| 3. Miscellaneous Property in Section | S _____ T _____ R _____ | _____ |
| | S _____ T _____ R _____ | _____ |

REC'D and FILED

DEC 20 1995

DONALD M. JOHNSON, County Clerk
ALGER COUNTY, MI

Register of Deeds Stamp & File Number

4. Lot No. _____, Recorded Plat _____
5. Private Claims _____

	A	B	C	D	E	F	G	H	I	J	K	L
2	6		5		4		3		2		1	
3												
4	7		8		9		10		11		12	
5												
6	18		17		16		15		14		13	
7												
8	19		20		21		22		23		24	
9												
10	30		29		28		27		26		25	
11												
12	31		32		33		34		35		36	
13												

I, Robert L. Jamros, in a field survey on September 08, 1995, 19_____, do hereby certify that under requirements of P.A. 74, Michigan P.A. of 1970, the corner points mentioned in lines 1 and 2 above were in conformance with regulations and rules therefore as required in the current manual of survey instructions of the United States Department of the Interior, Bureau of Land Management or by a decree of a Court of Law and/or that the corner points mentioned in lines 3, 4 and 5 above were in conformance with the rules of the Michigan Board of Professional Surveyors or by a Decree of a Court of Law; established, re-established, monumented, re-monumented, recovered, found as expressed below:

NOTE: Not more than 4 corners, all in the same town and range, may be recorded on this certificate.

A. Description of original monument and accessories and/or subsequent restoration:


L1: PLS-William A. Burt, DS, 1841, Set Or. Section Post- Maple 12", N.70 E., 15 links, Hemlock 14", N.32 W., 13 links. Alger County Road Commission survey note books, Walter W. Gleason, County Surveyor, 1913, Set standard iron corner from original government field notes. No references given. Volume 1, page 50 and 51. Corner position shown on MDSH Project plans No. 02022 and 2-28 for highway M-94. Monument material and witnesses not given. No other subsequent restoration found.

B. Description of corner evidence found and/or method applied in restoring or reestablishing corner:

L1: Found 2 inch galvanized iron pipe with 3 1/4 inch brass cap marked " 33 feet S. to 1/4s ", north of paved highway and 2 inch galvanized iron pipe with 3 1/4 inch brass cap marked " 33 feet N. to 1/4s ", south of paved highway, Author unknown. Also found was a 5/8 rebar in monument box 2.6 feet north of centerline of paved highway. Line and measurements north and south to brass capped monuments check very well and measurements to corners east and west along highway compare to highway records very well. A search was made at GLO bearing tree positions, evidence is lost. Corner position is accepted as the best available evidence of the position of the original corner.

C. Description of monument for corner and accessories established to perpetuate locating the position of the corner:

L1: Installed Berntsen Cap no. RB05325 stamped to identify corner position on existing 5/8" rebar. Established the following reference trees w/ BT signs, blazed, scribed and painted. Set PK nails for measure w/ Alum. I.D. washers in the following reference trees. Spruce 24", N.35 W., 81.33 feet, " 1/4s BT ", Maple 8", N.54 E., 58.38 feet, " 1/4s BT ", Maple 10", S.56 E., 81.06 feet, " 1/4s BT ", Cedar 6", S.51 W., 62.62 feet, " 1/4s BT ". All bearings are magnetic.

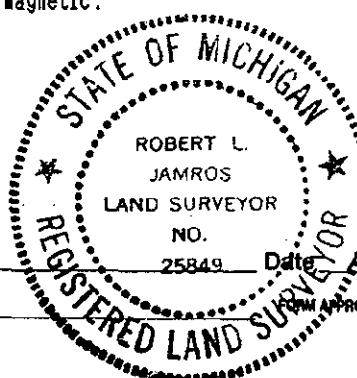

Signed by Robert L. Jamros
Surveyor's Michigan License No. 25849

Date 22 December 1995