

Approved by Alger County
 Land Survey Re-monumentation
 Peer Group Under Act 345 of
 P.A. of 1990 On 12-21-95
Michael W. Carter
 Chairman

SURVEY &
 MONUMENTATION

JAN 23 1996

LAND CORNER RECORDATION CERTIFICATE
Filing Requirement of Act 74, Mich. P.A. 1970

COMMISSION
 4-331

REC'D and FILED

DEC 23 1995
 2:45 p.m.
 DONALD W. JAMROS, County Clerk
 ALGER COUNTY, MI
 Register of Deeds Stamp & File Number

For corners in Alger Located In: _____ Corner Code # _____
 (County)

- 1. Public Land Survey T 46N R 18W M M13
 T 47N R 18W M M13
 T 46N R 17W M A1
 T 47N R 17W M A13
- 2. Property Controlling S _____ T _____ R _____
 in Section S _____ T _____ R _____
- 3. Miscellaneous S _____ T _____ R _____
 Property in Section S _____ T _____ R _____

- 4. Lot No. _____, Recorded Plat _____
- 5. Private Claims _____

	A	B	C	D	E	F	G	H	I	J	K	L
2	6		5		4		3		2			
3												
4	7		8		9		10		11		12	
5												
6	18		17		16		15		14		13	
7												
8	19		20		21		22		23		24	
9												
10	30		29		28		27		26		25	
11												
12	31		32		33		34		35		36	
13												

I, Robert L. Jamros, in a field survey on September 08, 1995, 19_____, do hereby certify that under requirements of P.A. 74, Michigan P.A. of 1970, the corner points mentioned in lines 1 and 2 above were in conformance with regulations and rules therefore as required in the current manual of survey instructions of the United States Department of the Interior, Bureau of Land Management or by a decree of a Court of Law and/or that the corner points mentioned in lines 3, 4 and 5 above were in conformance with the rules of the Michigan Board of Professional Surveyors or by a Decree of a Court of Law; established, re-established, monumented, re-monumented, recovered, found as expressed below:

NOTE: Not more than 4 corners, all in the same town and range, may be recorded on this certificate.

A. Description of original monument and accessories and/or subsequent restoration:

M1: PLS-William A. Burt, DS, 1841, Set Post Corner between town's 46 and 47 north- Tamarack 6', S.60 E., 146 links, Spruce 5', N.53 W., 102 links. Alger County Road Commission, Walter W. Gleason, County Surveyor, 1913, Set standard iron corner from original government field notes. No references given. Corner position shown on MDSH Project plans No. 02022 and 2-28 for highway M-94. Monument material and witnesses not given. CCI Forestry Division, Land and Timber Examination Report, R. Radcliffe, RLS, 1944, Notes on timber cruise map an iron corner at corner position. No references given.


B. Description of corner evidence found and/or method applied in restoring or reestablishing corner:

M1: Found 2 inch galvanized iron pipe with brass cap marked " 33 feet S. to Cor. ", north of paved highway and a 6 inch cedar post with Michigan Department of Conservation tag to identify corner marked " Cor. 33 feet S." Also found 2 inch galvanized iron pipe with 3 1/4 inch brass cap marked " 33 feet N. to Cor. ", south of paved highway. A search was made with a locator and results indicated a iron monument deep under highway. Established corner position on line between monuments and 33 feet south of north monument. Corner position is at location indicated by iron locator. Measurement to corner west along highway compares to highway records very well. A search was made at GLO bearing tree positions, evidence is lost. Corner position is accepted as the best available evidence of the position of the original corner.

C. Description of monument for corner and accessories established to perpetuate locating the position of the corner:

M1: Set 5/8" x 18" rebar w/ Berntsen Cap no. R8D5325 stamped to identify corner position. Established the following reference trees w/ BT signs, blazed, scribed and painted. Set PK nails for measure w/ Alum. I.D. washers in the following, reference tress. Tamarack 6', N.59 W., 85.68 feet, " S36 BT ", Cedar 5", N.40 E., 64.49 feet, " S31 BT ", Tamarack 8", S.43 E., 76.66 feet, " S6 BT ", P.Pole, S.63 W., 56.45 feet, " scribed BT @ ground level ". All bearings are magnetic.

Signed by Robert L. Jamros
 Surveyor's Michigan License No. 25849

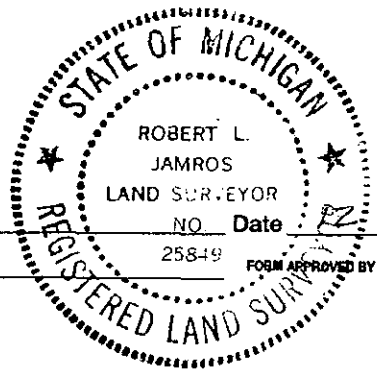

Date: 22 December 1995