

Harold Carlson  
Chairman

**LAND CORNER RECORDATION CERTIFICATE**  
Filing Requirement of Act 74, Mich. P.A. 1970

JAN 23 1996

4/350 COMMISSION

For corners in  
Alger  
(County)

Located In:

Corner Code #

1. Public Land Survey

T 47N R 22W A9  
T 47N R 23W M9 Marquette

2. Property Controlling  
in Section

S \_\_\_ T \_\_\_ R \_\_\_  
S \_\_\_ T \_\_\_ R \_\_\_

3. Miscellaneous  
Property in Section

S \_\_\_ T \_\_\_ R \_\_\_  
S \_\_\_ T \_\_\_ R \_\_\_

4. Lot No. \_\_\_\_\_, Recorded Plat \_\_\_\_\_

5. Private Claims \_\_\_\_\_

REC'D and FILED

JAN 23 1996  
2:45 p.m.  
DCV. ALGER COUNTY Clerk  
ALGER COUNTY, MI

Register of Deeds Stamp & File Number

Robert L. Jamros, in a field survey on June 29, 1995, 19\_\_\_\_\_, do hereby certify that under requirements of P.A. 74, Michigan P.A. of 1970, the corner points mentioned in lines 1 and 2 above were in conformance with regulations and rules therefore as required in the current manual of survey instructions of the United States Department of the Interior, Bureau of Land Management or by a decree of a Court of Law and/or that the corner points mentioned in lines 3, 4 and 5 above were in conformance with the rules of the Michigan Board of Professional Surveyors or by a Decree of a Court of Law; established, re-established, monumented, re-monumented, recovered, found as expressed below:

A	B	C	D	E	F	G	H	I	J	K	L
2	6	5	4	3	2						
3											
4	7	8	9	10	11	12					
5											
6	18	17	16	15	14	13					
7											
8	19	20	21	22	23	24					
9											
10	30	29	28	27	26	25					
11											
12	31	32	33	34	35	36					
13											

**NOTE: Not more than 4 corners, all in the same town and range, may be recorded on this certificate.**

**A. Description of original monument and accessories and/or subsequent restoration:**


A9: PLS-William A. Burt, DS, 1841, Set post corner of sections 19 & 30 - Tamarack 12", N.62 E., 50 links, Tamarack 10", N.80 W., 57 links. No Subsequent Restoration prior to 1973. Frank J. Bray, RLS, 1973, this corner was set mid-point and on line between section corners one mile north and one mile south. Established the following references. Cedar 4", N.16 E., 28.4', Cedar 9", N.57 W., 17. Recorded in Filing No. 37, Alger County Records.

**B. Description of corner evidence found and/or method applied in restoring or reestablishing corner:**

A9: Found 1" galvanized iron pipe with 4" aluminum cap stamped to identify corner position. Corner position reestablished by single proportionate measurement by Frank J. Bray, RLS, 1973. A search was made at GLO bearing tree locations, no evidence found. Established additional reference trees. Corner position is accepted as a careful and faithful reestablishment of the position of the original corner.

**C. Description of monument for corner and accessories established to perpetuate locating the position of the corner:**

A9: Stamped P.A. 345 in existing 4" Aluminum capped Michigan D.N.R. Monument. Renewed existing reference trees w/ BT signs and paint. Established additional reference trees w/ BT signs, blazed, scribed and painted. Set PK nails for measure w/ Alum. I.D. washers in the following reference trees. Ex. Cedar 10", N.53 W., 18.07 feet, " S24 NBT ", Ex. Cedar 7", N.20 E., 28.97 feet, " S19 NBT ", Cedar 4", S.35 E., 20.74 feet, " S30 BT ", Spruce 4", S.82 W., 5.60 feet, " S25 BT ", Survey Marker sign on six foot steel post, WEST, 0.70 feet. All bearings are magnetic.

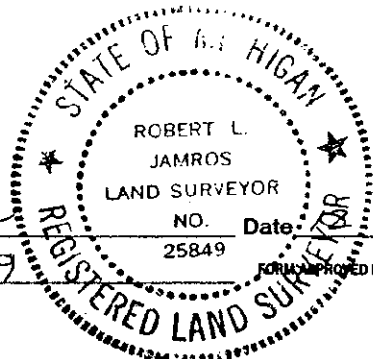

Signed by Robert L. Jamros  
Surveyor's Michigan License No. 25849

Date December 1995