

Approved by Alger County
Land Survey Remonumentation
Peer Group Under Act 345 of
P.A. of 1990 On 12-12-1995

JAN 23 1996

COMMISSION

4-355

Merrill W. Carlson
Chairman

LAND CORNER RECORDATION CERTIFICATE
Filing Requirement of Act 74, Mich. P.A. 1970

For corners in Alger <small>(County)</small>	Located In:	Corner Code #
1. Public Land Survey	T 47N R 22W	B9
	T _____ R _____	_____
	T _____ R _____	_____
	T _____ R _____	_____
2. Property Controlling in Section	S _____ T _____ R _____	_____
	S _____ T _____ R _____	_____
3. Miscellaneous Property in Section	S _____ T _____ R _____	_____
	S _____ T _____ R _____	_____

REC'D and FILED

DEC 23 1995
2:45 p.m.
DEPT. OF LAND & NATURAL RESOURCES
ALGER COUNTY, MI

Register of Deeds Stamp & File Number

4. Lot No. _____, Recorded Plat _____
5. Private Claims _____

A	B	C	D	E	F	G	H	I	J	K	L
2	6	5	4	3	2	1					
3											
4	7	8	9	10	11	12					
5											
6	18	17	16	15	14	13					
7											
8	19	20	21	22	23	24					
9											
10	30	29	28	27	26	25					
11											
12	31	32	33	34	35	36					
13											

I, Robert L. Jamros, in a field survey on June 29, 1995, 19_____, do hereby certify that under requirements of P.A. 74, Michigan P.A. of 1970, the corner points mentioned in lines 1 and 2 above were in conformance with regulations and rules therefore as required in the current manual of survey instructions of the United States Department of the Interior, Bureau of Land Management or by a decree of a Court of Law and/or that the corner points mentioned in lines 3, 4 and 5 above were in conformance with the rules of the Michigan Board of Professional Surveyors or by a Decree of a Court of Law; established, re-established, monumented, re-monumented, recovered, found as expressed below:

NOTE: Not more than 4 corners, all in the same town and range, may be recorded on this certificate.

A. Description of original monument and accessories and/or subsequent restoration:

B9: PLS-Alfred Millard, DS, 1852, Set Qr. Section Post- Hemlock 12", N.54 W., 30 links, Hemlock 14", S.30 E., 12 links. No Subsequent Restoration prior to 1973. Frank J. Bray, RLS, 1973, This corner was set by single proportionate measurement, between section corners east and west. Established the following references. Hemlock 6", S.38 E., 3.1', Hemlock 6", N.60 W., 11.1'. Recorded in filing No. 35, Alger County Records.


B. Description of corner evidence found and/or method applied in restoring or reestablishing corner:

B9: Found 1" galvanized iron pipe with 4" aluminum cap stamped to identify corner position. Corner position reestablished by single proportionate measurement by Frank J. Bray, RLS, 1973. A search was made at GLO bearing tree locations, no evidence found. Established additional reference trees. Corner position is accepted as a careful and faithful reestablishment of the position of the original corner.

C. Description of monument for corner and accessories established to perpetuate locating the position of the corner:

B9: Stamped P.A. 345 in existing 4" Aluminum capped Michigan. D.N.R. Monument. Renewed existing reference trees w/ BT signs and paint. Established additional reference trees w/ BT signs, blazed, scribed and painted. Set PK nails for measure w/ Alum. I.D. washers in the following reference trees. Ex. Hemlock 8", S.44 E., 3.13 feet, " Dbl. Blz'd.", Ex. Hemlock 8", N.54 W., 11.40 feet, " Dbl Blz'd.", Hemlock 18", N.53 E., 48.35 feet, " 1/4s BT ", Maple 6", S.68 E., 33.22 feet, " 1/4s BT ", Survey Marker sign on six foot steel post, N.24 W., 1.2 feet. All bearings are magnetic.

Signed by Robert L. Jamros
Surveyor's Michigan License No. 25849

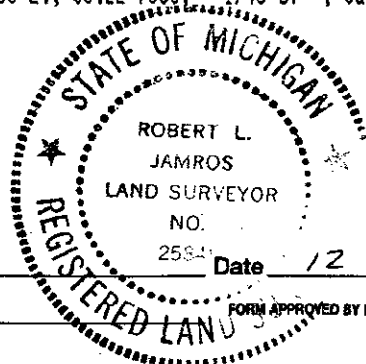

Date 12 December 1995