Approved by Alger County
Land Survey Remonumentation
Peer Group Under Act 345 of
P.A. of 1990 On 9/7 19 94
Mel Davis
ACTING Chairman
For corners in
Alger (County)

4-267

LAND CORNER RECORDATION CERTIFICATE

Filing Requirement of Act 74, Mich. P.A. 1970

FILED
TIME 2:35 p.m.
NOV 17 1994
DONALD W. KINNUNEN
REGISTER OF DEEDS

Register of Deeds Stamp & File Number

		Located In:	Corner Code ##
1. Public Land Survey		T 47N R 22W	03
		T ___ R ___	
		T ___ R ___	
		T ___ R ___	
2. *Property Controlling*	S ___	T ___ R ___	
in Section	S ___	T ___ R ___	
3. Miscellaneous	S ___	T ___ R ___	
Property in Sec.	S ___	T ___ R ___	

4. Lot No. _____ , Recorded Plat _____
5. Private Claims _____

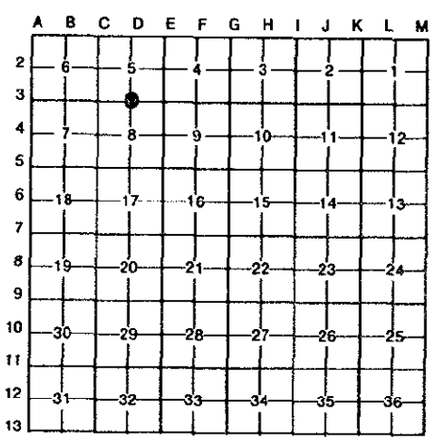

I, Robert L. Jamros, *in a field survey on* July 21, 1993, 19 ____, do hereby certify that under requirements of P.A. 74, Michigan P.A. of 1970, the corner points mentioned in lines 1 and 2 above were in conformance with regulations and rules therefore as required in the current manual of survey instructions of the United States Department of the Interior, Bureau of Land Management or by a decree of a Court of Law and/or that the corner points mentioned in lines 3, 4 and 5 above were in conformance with the rules of the Michigan Board of Land Surveyors or by a Decree of a Court of Law; established, re-established, monumented, re-monumented, recovered, found as expressed below:

NOTE: *Not more than 4 corners, all in the same town and range, may be recorded on this certificate.*

A. Description of original monument and accessories and/or subsequent restoration:

D3: P.L.S., Alfred Millard, DS, 1852. Set quarter section post. Hemlock 16, N.55 W., 10 links. Hemlock 8, S.58 E., 7 links. Alan K. Pierce, L.L.S., October 1991, Set a 1/2" x 24 ' rebar w/E.C.I. cap in concrete, equidistant on line between the recovered Southeast and Southwest corners of Section 5, both being recorded in Alger County Records. Approximately 250 feet South of centerline of Hwy M-28, established references. 11" Maple, N.86 E., 36.48 feet, 6" Maple, S.29 E., 19.32 feet, 5" Cedar, S.23 W., 17.36 feet, 7" Cedar, N.20 W., 20.88 feet, A.C. Recording NO. 4-156.

B. Description of corner evidence found and/or method applied in restoring or reestablishing corner:

D3: Found 1/2" rebar,identified by references on recorded report, set in concrete w/"E.C.I. - 30097" cap approx. 250 feet south of centerline of State Hwy M-28. A search was made for original BT's, two Hemlock trees, with inconclusive results. Installed monument over existing 1/2" rebar and renewed existing reference trees. Corner position was established equidistant on line, 2628.63 west-2628.63 east, between section corners by Alan K. Pierce in October 1991, and is accepted as a careful and faithful reestablishment of the position of the original corner.

C. Description of monument for corner and accessories established to perpetuate locating the position of the corner:

D3: Set 2 1/4" x 30" Alum. mon. w/3 1/4" Alum. cap stamped to I.D. corner. Renewed existing reference trees w/BT signs, blazed, scribed and painted. Set PK nails for measuring w/brass I.D. washers in the following reference trees. Ex. Cedar 8", N.21 W., 20.86 feet, "BT". Ex. Cedar 7", S.19 W., 17.40 feet, "BT". Ex. Maple 6", S.37 E., 19.33 feet, "BT". Ex. Maple 12", N.83 E., 36.43 feet, "BT". Survey Marker Sign, S.03 W., 0.60 feet.

Signed by Robert L. Jamros Date 10 July, 1994

Surveyor's Michigan License No. 25849

FORM APPROVED BY MICHIGAN STATE BOARD OF LAND SURVEYORS, JAN. 28, 1971
REVISED MAY 14, 1975
REVISED JAN., 1983