

Approved by Alger County
Land Survey Remonumentation
Peer Group Under Act 345 of
P.A. of 1990 On 12-12-1995

Donald W. Carlson
Chairman

LAND CORNER RECORDATION CERTIFICATE
Filing Requirement of Act 74, Mich. P.A. 1970

SURVEY &
MONUMENTAL
JAN 23 1996
COMMISSION
4-358

For corners in Alger Located In: Corner Code #
(County)

- | | | | | | |
|--------------------------------------|---|------------|---|------------|-------|
| 1. Public Land Survey | T | <u>47N</u> | R | <u>22W</u> | E12 |
| | T | _____ | R | _____ | _____ |
| | T | _____ | R | _____ | _____ |
| | T | _____ | R | _____ | _____ |
| 2. Property Controlling in Section | S | _____ | T | _____ | R |
| | S | _____ | T | _____ | R |
| 3. Miscellaneous Property in Section | S | _____ | T | _____ | R |
| | S | _____ | T | _____ | R |

REC'D and FILED
JAN 23 1996
2:45 p.m.
DONALD W. CARLSON, County Clerk
ALGER COUNTY, MI
Register of Deeds Stamp & File Number

4. Lot No. _____, Recorded Plat _____
5. Private Claims _____

A	B	C	D	E	F	G	H	I	J	K	L
2	6	5	4	3	2	1					
3											
4	7	8	9	10	11	12					
5											
6	18	17	16	15	14	13					
7											
8	19	20	21	22	23	24					
9											
10	30	29	28	27	26	25					
11											
12	31	32	33	34	35	36					
13											

I, Robert L. Jamros, in a field survey on June 26, 1995, 19_____, do hereby certify that under requirements of P.A. 74, Michigan P.A. of 1970, the corner points mentioned in lines 1 and 2 above were in conformance with regulations and rules therefore as required in the current manual of survey instructions of the United States Department of the Interior, Bureau of Land Management or by a decree of a Court of Law and/or that the corner points mentioned in lines 3, 4 and 5 above were in conformance with the rules of the Michigan Board of Professional Surveyors or by a Decree of a Court of Law; established, re-established, monumented, re-monumented, recovered, found as expressed below:


NOTE: Not more than 4 corners, all in the same town and range, may be recorded on this certificate.

A. Description of original monument and accessories and/or subsequent restoration:
E12: PLS-Alfred Millard, DS, 1852, Set Qr. Section Post- Maple 6", N.62 E., 16 links, Sugar 10", S.63 W., 6 links. CCI Forestry Division, Land corner record No. 260, R.J. Brotherton, RLS, 1948, 4' squared post at corner set by T.Billings from original GLO Maple BT still standing. No references given. No other subsequent restoration.

B. Description of corner evidence found and/or method applied in restoring or reestablishing corner:
E12: Found squared four inch post in downed position. Found original GLO bearing tree, Sugar 10" (now 24"), S.63 W., 6 links alive and standing with scribing readable through scar openings. A search was made at other GLO bearing tree location, inconclusive. Established corner position from original bearing tree and references. Corner position is accepted as a careful and faithful perpetuation of the position of the original corner.

C. Description of monument for corner and accessories established to perpetuate locating the position of the corner:
E12: Set Berntsen Mon. no. A1NB30, Stamped to identify corner position. Established the following reference trees w/ BT signs, blazed, scribed and painted. Set PK nails for measure w/ Alum. I.D. washers in the following reference trees. Maple 8", N.24 W., 28.39 feet, " 1/4s BT ", GLO Sugar 24", S.63 W., 3.96 feet, Maple 6", N.31 E., 91.21 feet, " 1/4s BT ", Beech 7", S.38 E., 58.72 feet, " 1/4s BT ", Survey Marker sign on six foot steel post, N.50 W., 0.80 feet. All bearings are magnetic.

Signed by Robert L. Jamros
Surveyor's Michigan License No. 25849

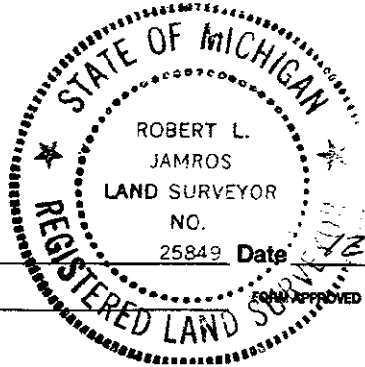

Date 17 December 1995