

JAN 23 1996

COMMISSION

4-351

Approved by Alger County
Land Survey Remonumentation
Peer Group Under Act 345 of
P.A. of 1990 On 12-12-1995

Gerald Wilson
Chairman

LAND CORNER RECORDATION CERTIFICATE
Filing Requirement of Act 74, Mich. P.A. 1970

For corners in Alger (County) Located In: Corner Code #

- 1. Public Land Survey T 47N R 22W E13
T 46N R 22W E1
T _____ R _____
T _____ R _____
- 2. Property Controlling S _____ T _____ R _____
in Section S _____ T _____ R _____
- 3. Miscellaneous S _____ T _____ R _____
Property in Section S _____ T _____ R _____
- 4. Lot No. _____, Recorded Plat _____
- 5. Private Claims _____

REC'D and FILED

JAN 23 1996
2:45 p.m.

Alger County Clerk

Register of Deeds Stamp & File Number

I, Robert L. Jamros, in a field survey on June 22, 1995, 19_____, do hereby certify that under requirements of P.A. 74, Michigan P.A. of 1970, the corner points mentioned in lines 1 and 2 above were in conformance with regulations and rules therefore as required in the current manual of survey instructions of the United States Department of the Interior, Bureau of Land Management or by a decree of a Court of Law and/or that the corner points mentioned in lines 3, 4 and 5 above were in conformance with the rules of the Michigan Board of Professional Surveyors or by a Decree of a Court of Law; established, re-established, monumented, re-monumented, recovered, found as expressed below:

A	B	C	D	E	F	G	H	I	J	K	L
2	6	5	4	3	2	1					
3											
4	7	8	9	10	11	12					
5											
6	18	17	16	15	14	13					
7											
8	19	20	21	22	23	24					
9											
10	30	29	28	27	26	25					
11											
12	31	32	33	34	35	36					
13											

NOTE: Not more than 4 corners, all in the same town and range, may be recorded on this certificate.

A. Description of original monument and accessories and/or subsequent restoration:

E13: PLS-William A. Burt, DS, 1841, Set post corner of sections 32 & 33 - Sugar 14", N.18 E., 28 links, Hemlock 28", N.25 W., 40 links. CCI Forestry Division, Land Corner Record, R.J. Brotherton, RLS, 1948, Old four inch post here. Established new references. Beech 4', N.60 W., 50 links, Sugar 9", N.32 1/2 E., 41 links. CCI Forestry Division, Land Corner Record, Page 638, Robin D. Steinhof, Found four inch hemlock post while marking timber at SE corner of section 32. No references were made.


B. Description of corner evidence found and/or method applied in restoring or reestablishing corner:

E13: Established corner position from reference trees of the report by R.J. Brotherton, RLS, 1948, Four inch post lost. A search was made at GLO bearing tree locations and found remains of hemlock in the NW position and traces of decayed maple in the NE position. GLO terrain call of 78.60 chains, Stream 4 links, C-NE, measures east of corner position very well. Established reference trees. Corner position is accepted as a careful and faithful perpetuation of the position of the original corner.

C. Description of monument for corner and accessories established to perpetuate locating the position of the corner:

E13: Set Berntsen Mon. no. A1NB30, stamped to identify corner position. Established the following reference trees w/ BT signs, blazed, scribed and painted. Set PK nails for measure w/ Alum. I.D. washers in the following reference trees. Y.Birch 8", N.31 W., 21.66 feet, ' S32 BT ', Hemlock 7', S.71 E., 27.18 feet, ' S4 BT ', Maple 8', S.16 W., 22.72 feet, ' S5 BT ', Beech 3", N.53 E., 33.88 feet, ' S33 BT ', Survey Marker sign on six foot steel post, N.46 W., 1.0 feet. All bearings are magnetic.

Signed by Robert L. Jamros
Surveyor's Michigan License No. 25849

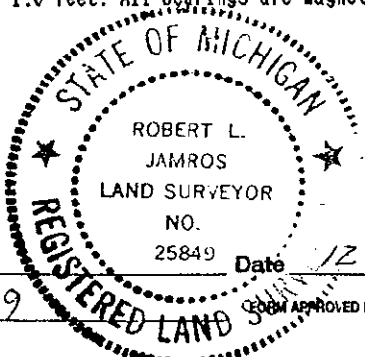

Date 12 December 1995