

Approved by Alger County
Land Survey Remonumentation
Peer Group Under Act 345 of
P.A. of 1990 On 12-12-1995

RECORDS
DOCUMENTATION

JAN 29 1996

Sheldon Carlson
Chairman

LAND CORNER RECORDATION CERTIFICATE
Filing Requirement of Act 74, Mich. P.A. 1970

COMMISSION
4-357

For corners in Alger Located In: _____ Corner Code # _____
(County)


- | | | | | | | |
|--------------------------------------|---|-------|---|-------|-------|-------|
| 1. Public Land Survey | T | 47N | R | 22W | G11 | _____ |
| | T | _____ | R | _____ | _____ | _____ |
| | T | _____ | R | _____ | _____ | _____ |
| | T | _____ | R | _____ | _____ | _____ |
| 2. Property Controlling in Section | S | _____ | T | _____ | R | _____ |
| | S | _____ | T | _____ | R | _____ |
| 3. Miscellaneous Property in Section | S | _____ | T | _____ | R | _____ |
| | S | _____ | T | _____ | R | _____ |

REC'D and FILED

DEC 28 1995
2:45 p.m.
DORIS W. WATSON, County Clerk
ALGER COUNTY, MI

Register of Deeds Stamp & File Number

4. Lot No. _____, Recorded Plat _____
5. Private Claims _____

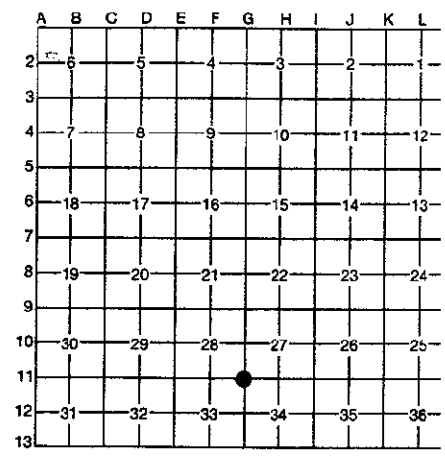

I, Robert L. Jamros, in a field survey on June 26, 1995, 19_____, do hereby certify that under requirements of P.A. 74, Michigan P.A. of 1970, the corner points mentioned in lines 1 and 2 above were in conformance with regulations and rules therefore as required in the current manual of survey instructions of the United States Department of the Interior, Bureau of Land Management or by a decree of a Court of Law and/or that the corner points mentioned in lines 3, 4 and 5 above were in conformance with the rules of the Michigan Board of Professional Surveyors or by a Decree of a Court of Law; established, re-established, monumented, re-monumented, recovered, found as expressed below:


NOTE: Not more than 4 corners, all in the same town and range, may be recorded on this certificate.

A. Description of original monument and accessories and/or subsequent restoration:
G11: PLS-Alfred Millard, DS, 1852, Set post corner of sections 27, 28, 33 & 34 - W. Pine 8", N. 45 W., 10 links, Cedar 8", S. 38 E., 10 links. CCI Forestry Division, Land Corner Record, Page 338, J.R. Radcliffe, RLS, Found iron with brass cap. new references. Tamarack 8", West, 17 links, Tamarack 10", N. 85 E., 38 links. CCI Forestry Division, Land Corner Record, Page 981, Robin D. Steinhof, 1967, Found brass cap iron at NE corner of section 33. Established new references. Black Spruce 6", N. 10 E., 9 1/2 links, Cedar 8", N. 75 W., 21 links.

B. Description of corner evidence found and/or method applied in restoring or reestablishing corner:
G11: Found two inch cast iron bar with brass cap stamped to identify corner position, dated Oct. 30, 1910. Verified remaining references of Land Corner Record of J.R. Radcliffe, RLS, and Robin D. Steinhof, 1967. A search was made at GLO bearing tree locations and at the N. 45 W., 10 link position found solid remains identified as white pine. Established additional reference trees. Corner position is accepted as a careful and faithful perpetuation of the position of the original corner.

C. Description of monument for corner and accessories established to perpetuate locating the position of the corner:
G11: Stamped P.A. 345 in brass cap of cast steel monument. Renewed existing reference trees w/ BT signs and paint. Established additional reference trees w/ BT signs, blazed, scribed and painted. Set PK nails for measure w/ Alum. I.D. washers in the following reference trees. Ex. Tamarack 10", N. 81 E., 25.28 feet, " S27 BT ", Ex. Cedar. 8", N. 74 W., 21.10 feet, " upper blz & BT ", Cedar 12", S. 50 E., 47.05 feet, S34 BT ", Cedar 10", N. 10 W., 29.42 feet, " S28 BT ", Survey Marker sign on six foot steel post, S. 33 W., 1.3 feet. All bearings are magnetic.

Signed by Robert L. Jamros
Surveyor's Michigan License No. 25849

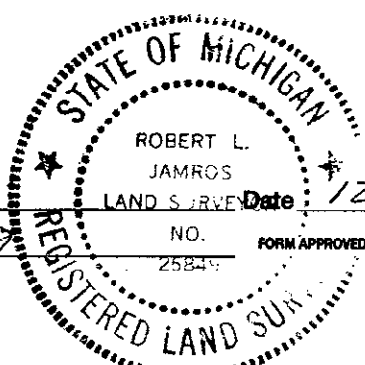

Date 12 December 1995

FORM APPROVED BY MICHIGAN STATE BOARD OF PROFESSIONAL SURVEYORS, JAN. 28, 1971
REVISED MAY 14, 1975
REVISED JAN., 1983