

Approved by Alger County
 Land Survey Re-enumeration
 Peer Group Under Act 345 of
 P.A. of 1990 On 12-21-95

Robert L. Jamros
 Chairman

For Alger in
 (County)

LAND CORNER RECORDATION CERTIFICATE

Filing Requirement of Act 74, Mich. P.A. 1970

JAN 23 1996

COMMISSION

Located In: Corner Code #

- | | | |
|--------------------------------------|---------------------------|------------|
| 1. Public Land Survey | T <u>47N</u> R <u>22W</u> | <u>G13</u> |
| | T <u>46N</u> R <u>22W</u> | <u>G1</u> |
| | T _____ R _____ | _____ |
| | T _____ R _____ | _____ |
| 2. Property Controlling in Section | S _____ T _____ R _____ | _____ |
| | S _____ T _____ R _____ | _____ |
| 3. Miscellaneous Property in Section | S _____ T _____ R _____ | _____ |
| | S _____ T _____ R _____ | _____ |

REC'D and FILED

JAN 23 1996
 2:45 p.m.
 DEPT. OF STATE

Register of Deeds Stamp & File Number

4. Lot No. _____, Recorded Plat _____
 5. Private Claims _____

A	B	C	D	E	F	G	H	I	J	K	L
2	6		5		4		3		2		1
3											
4	7		8		9		10		11		12
5											
6	18		17		16		15		14		13
7											
8	19		20		21		22		23		24
9											
10	30		29		28		27		26		25
11											
12	31		32		33		34		35		36
13											

Robert L. Jamros, in a field survey on July 05, 1995, 19_____, do hereby certify that under requirements of P.A. 74, Michigan P.A. of 1970, the corner points mentioned in lines 1 and 2 above were in conformance with regulations and rules therefore as required in the current manual of survey instructions of the United States Department of the Interior, Bureau of Land Management or by a decree of a Court of Law and/or that the corner points mentioned in lines 3, 4 and 5 above were in conformance with the rules of the Michigan Board of Professional Surveyors or by a Decree of a Court of Law; established, re-established, monumented, re-monumented, recovered, found as expressed below:

NOTE: Not more than 4 corners, all in the same town and range, may be recorded on this certificate.

A. Description of original monument and accessories and/or subsequent restoration:


G13: PLS- William A. Burt, DS, 1841, Set Post Corner of Sections 33 and 34 - Hemlock 14', N.37 E., 21 links, Hemlock 10', N.22 W., 30 links. No other subsequent restoration.

B. Description of corner evidence found and/or method applied in restoring or reestablishing corner:

G13: Found 2" cast iron bar with brass cap stamped to identify corner position dated Oct. 30, 1910. A search was made at GLO bearing tree locations. At N.37 E., 21 links, Hemlock 14', found decayed root system identified as hemlock. At N.22 W., 30 links, Hemlock 10', found stump hole with decayed wood identified as hemlock. Corner position is accepted as a careful and faithful perpetuation of the position of the original corner.

C. Description of monument for corner and accessories established to perpetuate locating the position of the corner:

G13: Stamped P.A. 345 in brass cap of cast steel monument. Established the following reference trees w/ BT signs, blazed, scribed and painted. Set PK nails for measure w/ Alum. I.D. washers in the following reference trees. Maple 4", N.57 W., 19.02 feet, " S33 BT ", Maple 8", N.27 E., 35.19 feet, " S34 BT ", Maple 7", S.30 W., 51.79 feet, " S4 BT ", Hemlock 10", S.68 E., 57.13 feet, " S3 BT ", Survey Marker sign on six foot steel post, S.33 E., 1.1 feet. All bearings are magnetic.

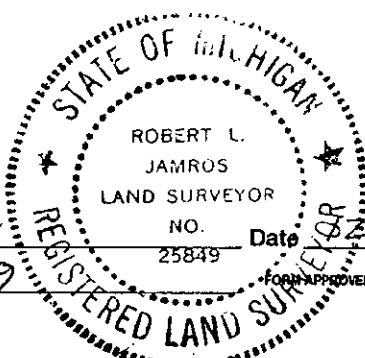

Signed by Robert L. Jamros Date December 1995

Surveyor's Michigan License No. 25849