

Approved by Alger County  
Land Survey Remonumentation  
Peer Group Under Act 345 of  
P.A. of 1990 On 12-12-1995

JAN 28 1996

Hubert W. Carlson  
Chairman

**LAND CORNER RECORDATION CERTIFICATE**  
Filing Requirement of Act 74, Mich. P.A. 1970

COMMISSION  
4-354

For corners in Alger (County)	Located In:	Corner Code #
1. Public Land Survey	T 47N R 22W	H11
	T _____ R _____	_____
	T _____ R _____	_____
	T _____ R _____	_____
2. Property Controlling in Section	S _____ T _____ R _____	_____
	S _____ T _____ R _____	_____
3. Miscellaneous Property in Section	S _____ T _____ R _____	_____
	S _____ T _____ R _____	_____

**REC'D and FILED**

JAN 28 1996  
2:45 p.m.  
DONALD W. WAINWRIGHT, County Clerk  
ALGER COUNTY, MI

Register of Deeds Stamp & File Number

4. Lot No. \_\_\_\_\_, Recorded Plat \_\_\_\_\_  
5. Private Claims \_\_\_\_\_

	A	B	C	D	E	F	G	H	I	J	K	L	I
2	6		5		4		3		2		1		
3													
4	7		8		9		10		11		12		
5													
6	18		17		16		15		14		13		
7													
8	19		20		21		22		23		24		
9													
10	30		29		28		27		26		25		
11													
12	31		32		33		34		35		36		
13													

Robert L. Jamros, in a field survey on June 20, 1995, do hereby certify that under requirements of P.A. 74, Michigan P.A. of 1970, the corner points mentioned in lines 1 and 2 above were in conformance with regulations and rules therefore as required in the current manual of survey instructions of the United States Department of the Interior, Bureau of Land Management or by a decree of a Court of Law and/or that the corner points mentioned in lines 3, 4 and 5 above were in conformance with the rules of the Michigan Board of Professional Surveyors or by a Decree of a Court of Law; established, re-established, monumented, re-monumented, recovered, found as expressed below:

**NOTE: Not more than 4 corners, all in the same town and range, may be recorded on this certificate.**

**A. Description of original monument and accessories and/or subsequent restoration:**

H11: PLS-Alfred Millard, DS, 1852, Set Or. Section Post- Hemlock 8", N.30 W., 40 links, Hemlock 12", S.25 E., 22 links. CCI Forestry Division, Land corner record No. 337, J.R. Radcliffe, RLS, 1964, Original GLO BT here in NW position. Set new cedar post and one new reference, Hemlock 10", S.30 W., 54.5 links. Mead Corporation, Robert E. Schmeling, RLS, 1972, Found 3' Sq. post and original GLO BT. Set G.I.P. w/ brass cap and established the following new references. Hemlock 10", S.34 W., 40.25', Y.Birch 15", S.82 E., 18.75'. Recorded in filing No. 409, Alger County Records.


**B. Description of corner evidence found and/or method applied in restoring or reestablishing corner:**

H11: Found 1 1/4" galvanized iron pipe with brass cap stamped to identify corner position dated 1972. Found original GLO BT alive and standing in the position of N.30 W., 40 links, Hemlock 8" (now 28") and reference trees of the 1972 Land corner record. Verified existing references and established additional reference trees. Corner position is accepted as a careful and faithful perpetuation of the position of the original corner.

**C. Description of monument for corner and accessories established to perpetuate locating the position of the corner:**

H11: Stamped P.A. 345 in brass cap of galvanized iron pipe monument. Renewed existing reference trees w/ BT signs and paint. Established additional reference trees w/ BT signs, blazed, scribed and painted. Set PK nails for measure w/ Alum. I.D. washers in the following reference trees. Ex. Hemlock 14", S.35 W., 40.42 feet, " Dbl. Blz'd.", Ex. Y.birch 17", S.83 E., 18.55 feet, " Dbl. Blz'd.", Ex. Hemlock 28", N.30 W., 26.92 feet, " GLO scribing visible ", Maple 5", N.17 1/2 E., 32.74 feet, " 1/4s BT ", Survey Marker sign on six foot steel post, N.37 E., 1.7 feet. All bearings are magnetic.

Signed by Robert L. Jamros  
Surveyor's Michigan License No. 25849

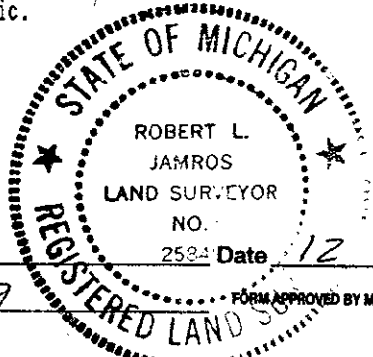

Date 12 December 1995