

Approved by Alger County
Land Survey Remonumentation
Peer Group Under Act 345 of
P.A. of 1990 On 12-12-1995

JAN 23 1996

COMMISSION

4-356

M. W. Carlson
Chairman

LAND CORNER RECORDATION CERTIFICATE
Filing Requirement of Act 74, Mich. P.A. 1970

For corners in Alger (County) Located In: Corner Code #

1. Public Land Survey	T	47N	R	22W	I11
	T		R		
	T		R		
	T		R		
2. Property Controlling in Section	S		T		R
	S		T		R
3. Miscellaneous Property in Section	S		T		R
	S		T		R

REC'D and FILED


JAN 20 1996
2:45 p.m.

ALGER COUNTY CLERK
ALGER COUNTY, MI

Register of Deeds Stamp & File Number

4. Lot No. _____, Recorded Plat _____
5. Private Claims _____

I, Robert L. Jamros, in a field survey on June 22, 0095, 19_____, do hereby certify that under requirements of P.A. 74, Michigan P.A. of 1970, the corner points mentioned in lines 1 and 2 above were in conformance with regulations and rules therefore as required in the current manual of survey instructions of the United States Department of the Interior, Bureau of Land Management or by a decree of a Court of Law and/or that the corner points mentioned in lines 3, 4 and 5 above were in conformance with the rules of the Michigan Board of Professional Surveyors or by a Decree of a Court of Law; established, re-established, monumented, re-monumented, recovered, found as expressed below:

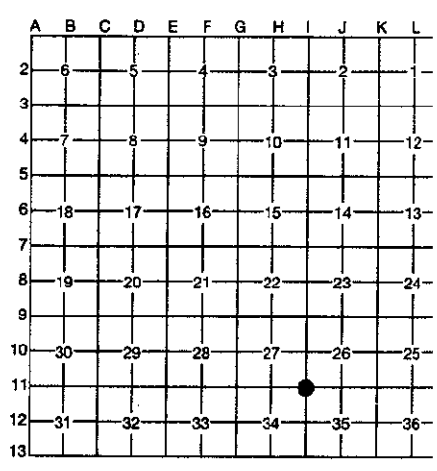


NOTE: Not more than 4 corners, all in the same town and range, may be recorded on this certificate.

A. Description of original monument and accessories and/or subsequent restoration:
I11: PLS-Alfred Millard, DS, 1852, Set post corner of sections 26,27,34 & 35 - Sugar 12", S.80 E., 24 links, Sugar 10", N.40 W., 65 links. CCI Forestry Division, Land and Timber examination Report, R.J. Brotherton, RLS, 1940, Corner shown on timber cruise map as a iron with bronze top and 20" Maple government BT. No references were given.

B. Description of corner evidence found and/or method applied in restoring or reestablishing corner:
I11: Found two inch cast iron bar with brass cap stamped to identify corner position dated Oct. 31, 1910. A search was made at GLO bearing tree locations and evidence of twenty inch maple government bearing tree has been destroyed by logging operations. Corner position is accepted as a careful and faithful perpetuation of the position of the original corner.

C. Description of monument for corner and accessories established to perpetuate locating the position of the corner:
I11: Stamped P.A. 345 in brass cap of cast steel monument. Renewed existing reference tree w/ BT signs and paint. Established additional reference trees w/ BT sign, blazed, scribed and painted. Set PK nails for measure w/ Alum. I.D. washers in the following reference trees. Ex. Maple 20", S.44W., 14.18 feet, " Dbl. Blz'd.", Maple 6", S.55 E., 30.23 feet, " S35 BT ", Maple 7", N.68 E., 18.07 feet, " S26 BT ", Ironwood 5", N.38 W., 42.52 feet, " S27 BT ", Survey Marker sign on six foot steel post, S.22 E., 1.0 feet. All bearings are magnetic.

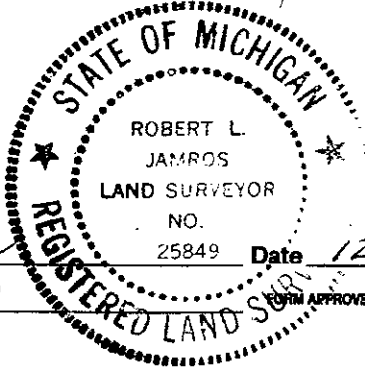

Signed by Robert L. Jamros
Surveyor's Michigan License No. 25849

Date 12 December 1995