

Approved by Alger County Land Survey Remonumentation Peer Group Under Act 345 of P.A. of 1990 On 12-12-1995

JAN 23 1996

LAND CORNER RECORDATION CERTIFICATE Filing Requirement of Act 74, Mich. P.A. 1970

COMMISSION

4-353

Chairman For corners in Alger (County)

Located In:

Corner Code #

- 1. Public Land Survey T 47N R 22W K12
2. Property Controlling in Section S T R
3. Miscellaneous Property in Section S T R

REC'D and FILED

JAN 20 1996 2:45 p.m.

DONALD W. HANSEN, County Clerk ALGER COUNTY, MI

Register of Deeds Stamp & File Number

- 4. Lot No. , Recorded Plat
5. Private Claims

Grid table with columns A-L and rows 1-13. Cell (12, 36) contains a black dot.

I, Robert L. Jamros, in a field survey on July 05, 1995, do hereby certify that under requirements of P.A. 74, Michigan P.A. of 1970, the corner points mentioned in lines 1 and 2 above were in conformance with regulations and rules therefore as required in the current manual of survey instructions of the United States Department of the Interior, Bureau of Land Management or by a decree of a Court of Law and/or that the corner points mentioned in lines 3, 4 and 5 above were in conformance with the rules of the Michigan Board of Professional Surveyors or by a Decree of a Court of Law; established, re-established, monumented, re-monumented, recovered, found as expressed below:

NOTE: Not more than 4 corners, all in the same town and range, may be recorded on this certificate.

A. Description of original monument and accessories and/or subsequent restoration:


K12: PLS-Alfred Millard, DS, 1852, Set Or. Section Post - Y.Birch 15", S.55 E., 29 links, Hemlock 12", N.40 W., 33 links. George Depew, County Surveyor, 1918, Set Standard iron corner on true line and at equal distance. No references given. Record of Surveys book, Page 450, Alger County Records. CCI Forestry Division, Land Corner Record No. 544, J.R. Radcliffe, RLS, 1965, Corner just south of log road, Government Y.Birch BT (S.55 E., 29 links) stub here, scribe marks visible. Established the following references. Sugar 9', N.12 E., 23 links, Maple 6", S.00 E., 32 links.

B. Description of corner evidence found and/or method applied in restoring or reestablishing corner:

K12: Found 2" cast iron bar with 3 1/4" brass cap stamped to identify corner position, dated Nov. 9, 1910. A search was made at GLO bearing tree positions. At S.55 E., 29 links found decayed wood and bark remains identified as yellow birch. Found and verified reference position of land corner record by J.R. Radcliffe, RLS, 1965. Corner position is accepted as a careful and faithful perpetuation and reestablishment of the position of the original corner.

C. Description of monument for corner and accessories established to perpetuate locating the position of the corner:

K12: Stamped P.A. 345 in brass cap of cast steel monument. Renewed existing reference trees w/ BT signs and paint. Established additional reference trees w/ BT signs, blazed, scribed, and painted. Set PK nails for measure w/ Alum. I.D. washers in the following reference trees. Ex. Hemlock 16", N.79 W., 5.50 feet, " upper Blz. scribed BT ", Ex. Maple 14", S.05 W., 22.77 feet, " Obl. Blz'd.", Ex. Maple 12", N.38 W., 25.64 feet, " Obl. Blz'd.", Maple 5", S.80 E., 19.07 feet, " 1/4s BT ", Survey Marker sign on six foot steel post, N.27 E., 1.3 feet. All bearings are magnetic.

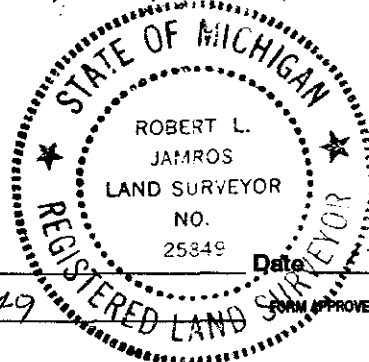

Signed by Robert L. Jamros

Date 22 December 1995

Surveyor's Michigan License No. 25849