

# LAND CORNER RECORDATION CERTIFICATE

FILING REQUIREMENT OF ACT 74, MICH. P.A.1970

FOR CORNERS OF --:	LOCATED IN--:	CORNER CODE NUMBER	
1. PUBLIC LAND SURVEY.....	T. <u>47</u> N. R. <u>22</u> W.	<u>C-6, C-7</u>	
2. PROPERTY CONTROLLING IN SECTION.....	T. .... N. S., R. .... E. W.		
3. MISCELLANEOUS PROPERTY IN SECTION.....	T. .... N. S., R. .... E. W.		
4. LOT NO. ...., RECORDED PLAT.....			
5. PRIVATE CLAIMS.....			

REGISTER OF DEEDS STAMP AND FILING NUMBER

I, Frank J. Bray do hereby certify that under requirements of P.A. 74, Michigan P.A. of 1970, the corner points mentioned in lines 1 and 2 above (identified with circles on index code diagram - over) were, in a field survey on 10-11 19 73, established, re-established, monumented, re-monumented, recovered or restored as expressed below and in conformance with regulations and rules therefore as required in the current manual of survey instructions of the United States Department of the Interior, Bureau of Land Management or by a decree of a court of law. Furthermore, that the corner points mentioned in lines 3, 4 and 5 above were, in a field survey on \_\_\_\_\_ 19 \_\_\_\_\_, found, recovered, restored, established or re-established as expressed below and in conformance with the rules of the Michigan State Board of Registration for Land Surveyors or, by a Decree of a Court of law:

A. Description of original monument and accessories and/or subsequent restoration:

**Woodpost:**

**C-6 Hemlock 20 N68°E 31 links      C-7 Hemlock 12 S36°E 28 links**  
**Hemlock 24 S42°W 45 links**  
 Subsequent Monument: Woodpost

B. Description of corner evidence found and/or method applied in restoring or re-establishing corner:

**C-6 This corner was replaced from point of old woodpost which is the proper distance & bearing from original B.T. (Hemlock stump with scribe marks on lower face) to the SW.**

**C-7 This corner was set by double proportionate measurement from 1/4 corner east and north and section corners south and west.**

C. Description of monument for corner and accessories established to perpetuate locating the position of the corner:

**All: 1" iron pipe with 1/2" aluminum cap. All bearings are magnetic.**

**C-6 16" Cedar (1/8) (NBT) N88°E 33.6'**  
**1 1/2" Hemlock (1/8) (NBT) S71°W 38.0'**

**C-7 9" Hemlock (B20) (NBT) S40°E 18.9'**  
**1/2" W. Pine (S18) (NBT) N38°W 21.5'**

SIGNED BY: \_\_\_\_\_ DATE: \_\_\_\_\_

SURVEYOR'S MICHIGAN REGISTRATION NO. \_\_\_\_\_ (SEAL)

FOR STATE AND UNITED STATES AGENCIES:


SIGNED BY: \_\_\_\_\_ DATE: \_\_\_\_\_

APPROVED AND SIGNED BY: Frank J. Bray DATE: 10-24-73  
MICHIGAN REGISTERED LAND SURVEYOR (SEAL)

SURVEYOR'S MICHIGAN REGISTRATION NO. 13575


**CORNER NUMBERING CODE DIAGRAMS FOR IDENTIFYING LAND CORNER  
RECORDATIONS AND INDEXING**

FOR PUBLIC LAND SURVEY CORNERS IN THE  
T. 47N, R. 22W (MENTIONED OVER)

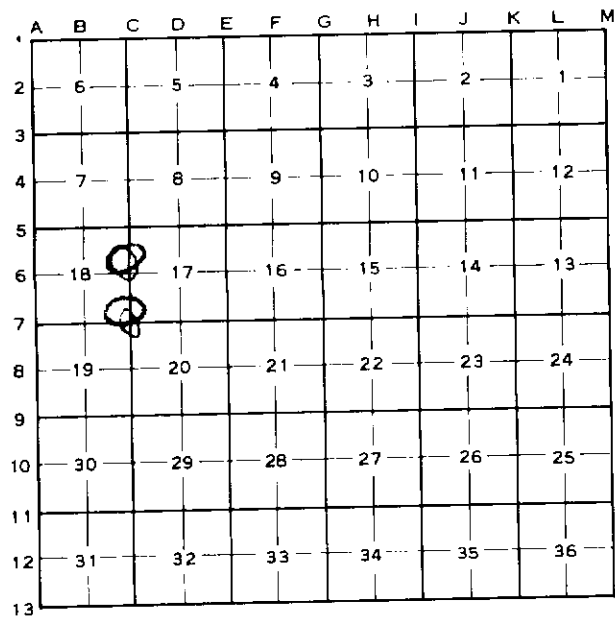

Apply letter prefix for corner points encircled above  
for identifying corner recordation numbers over.

FOR PROPERTY CONTROLLING AND MISC.  
PROPERTY CORNERS WITHIN THE SECTION  
(MENTIONED OVER AND EXCLUDE LOT CORNER)

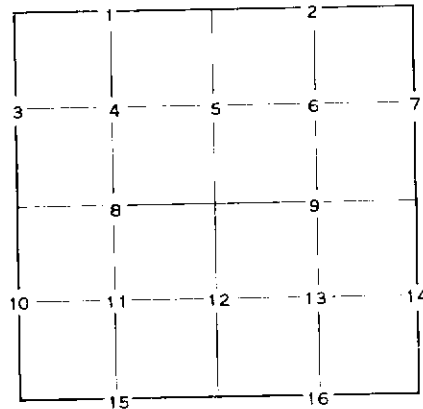

1. Above coded numbers are positioned on 1/16 fractional lines of the section.
2. Township corner code numbers shall be applied to corners of above typical section not numbered.
3. Miscellaneous property corners within a section, located at points other than numbered above, shall be referenced to at least two of above corner code numbers.
4. Private claim corners to be tied to rectangular land corners if possible - sketch required below.

**EXPLANATORY SKETCH IF NECESSARY -- BELOW**