

# LAND CORNER RECORDATION CERTIFICATE

## FILING REQUIREMENT OF ACT 74, MICH. P.A.1970

FOR CORNERS OF --:	LOCATED IN --:	CORNER CODE NUMBER
1. PUBLIC LAND SURVEY _____	T. <u>47</u> N. <del>R.</del> <u>22</u> W. <del>E.</del>	<u>C-8</u>
2. PROPERTY CONTROLLING IN SECTION <u>19</u>	T. <u>47</u> N. <del>S.</del> <u>22</u> W. <del>E.</del>	<u>7, 14</u>
3. MISCELLANEOUS PROPERTY IN SECTION _____	T. _____ N. _____ R. _____ E. _____	
4. LOT NO. _____, RECORDED PLAT _____		
5. PRIVATE CLAIMS _____		

REGISTER OF DEEDS STAMP AND  
 FILING NUMBER \_\_\_\_\_

I, Frank J. Bray do hereby certify that under requirements of P.A. 74, Michigan P.A. of 1970, the corner points mentioned in lines 1 and 2 above (identified with circles on index code diagram - over) were, in a field survey on October 12 19 73, established, re-established, monumented, re-monumented, recovered or restored as expressed below and in conformance with regulations and rules therefore as required in the current manual of survey instructions of the United States Department of the Interior, Bureau of Land Management or by a decree of a court of law. Furthermore, that the corner points mentioned in lines 3, 4 and 5 above were, in a field survey on \_\_\_\_\_ 19 \_\_\_\_\_, found, recovered, restored, established or re-established as expressed below and in conformance with the rules of the Michigan State Board of Registration for Land Surveyors or, by a Decree of a Court of law:

A. Description of original monument and accessories and/or subsequent restoration:

**C-8 Woodpost:**

Spruce	6	N58°E	33 links
Spruce	6	S68°W	60 links

B. Description of corner evidence found and/or method applied in restoring or re-establishing corner:

- C-8** This corner was set mid-point and on a line between section corners north and south.
- 7** This corner was set mid-point and on a line between section corner north and 1/4 corner south. Corner lies on north edge of small stream.
- 14** This corner was set mid-point on a line between section corner south and 1/4 corner north.

C. Description of monument for corner and accessories established to perpetuate locating the position of the corner:

All: 1" pipe with 1/4" aluminum cap. All bearings are magnetic.

<b>C-8</b>	10" W. Pine (1/2S)	(NBT)	S43°E	25.3'
	18" W. Pine (1/2S)		N83°E	31.0'
<b>7</b>	9" B. Spruce (N 1/16)	(BT)	N68°E	13.8'
	10" Hemlock (N 1/16)	(BT)	N36°W	11.2'
<b>14</b>	9" B. Spruce (S 1/16)	(BT)	N63°E	1.2'
	9" Cedar (S 1/16)	(BT)	N38°W	10.9'

SIGNED BY \_\_\_\_\_ DATE \_\_\_\_\_

SURVEYOR'S MICHIGAN REGISTRATION NO. \_\_\_\_\_ (SEAL)

FOR STATE AND UNITED STATES AGENCIES:


SIGNED BY \_\_\_\_\_ CHIEF OF SURVEY PARTY DATE \_\_\_\_\_

APPROVED AND SIGNED BY Frank J. Bray DATE 10-22-73  
MICHIGAN REGISTERED LAND SURVEYOR (SEAL)

SURVEYOR'S MICHIGAN REGISTRATION NO. 13575


**CORNER NUMBERING CODE DIAGRAMS FOR IDENTIFYING LAND CORNER RECORDATIONS AND INDEXING**

FOR PUBLIC LAND SURVEY CORNERS IN THE  
T. ~~47N~~, R. ~~22W~~ (MENTIONED OVER)

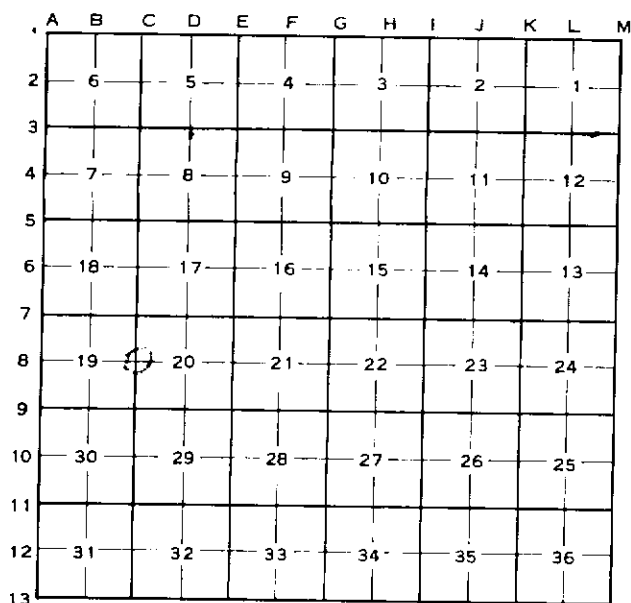

Apply letter prefix for corner points encircled above for identifying corner recordation numbers over.

FOR PROPERTY CONTROLLING AND MISC. PROPERTY CORNERS WITHIN THE SECTION (MENTIONED OVER AND EXCLUDE LOT CORNER)

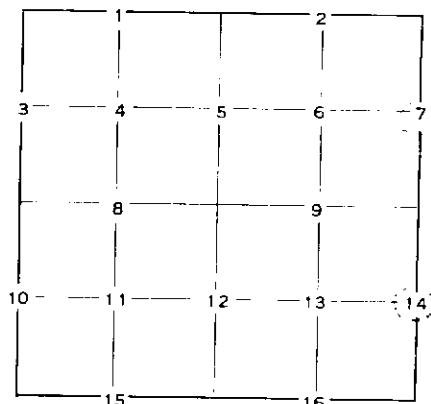

1. Above coded numbers are positioned on 1/16 fractional lines of the section.
2. Township corner code numbers shall be applied to corners of above typical section not numbered.
3. Miscellaneous property corners within a section, located at points other than numbered above, shall be referenced to at least two of above corner code numbers.
4. Private claim corners to be tied to rectangular land corners if possible - sketch required below.

EXPLANATORY SKETCH IF NECESSARY -- BELOW