

LAND CORNER RECORDATION CERTIFICATE

FILING REQUIREMENT OF ACT 74, MICH. P.A.1970

FOR CORNERS OF --:	LOCATED IN --:	CORNER CODE NUMBER
1. PUBLIC LAND SURVEY.....	T. <u>47</u> N. R. <u>22, 23</u> W.	<u>A-10, A-11</u>
2. PROPERTY CONTROLLING IN SECTION <u>30</u>	T. <u>47</u> N. R. <u>22, 23</u> W.	<u>10</u>
3. MISCELLANEOUS PROPERTY IN SECTION _____	T. _____ N. S. R. _____ E. W.	_____
4. LOT NO. _____, RECORDED PLAT _____		
5. PRIVATE CLAIMS _____		

REGISTER OF DEEDS STAMP AND FILING NUMBER _____

I, Frank J. Bray do hereby certify that under requirements of P.A. 74, Michigan P.A. of 1970, the corner points mentioned in lines 1 and 2 above (identified with circles on index code diagram-over) were, in a field survey on October 15 1973, established, re-established, monumented, re-monumented, recovered or restored as expressed below and in conformance with regulations and rules therefore as required in the current manual of survey instructions of the United States Department of the Interior, Bureau of Land Management or by a decree of a court of law. Furthermore, that the corner points mentioned in lines 3, 4 and 5 above were, in a field survey on _____ 19____, found, recovered, restored, established or re-established as expressed below and in conformance with the rules of the Michigan State Board of Registration for Land Surveyors or, by a Decree of a Court of law:

A. Description of original monument and accessories and/or subsequent restoration:

A-10 Woodpost: Sugar 15 N41°E 35 links Beech 18 N18°W 36 links	A-11 Woodpost: Tamarack 12 N27°E 70 links Tamarack 8 N21°W 12 links
---	--

B. Description of corner evidence found and/or method applied in restoring or re-establishing corner:

A-10 This corner was set mid-point and on a line between section corners north & south.

A-11 This corner was replaced from 2 original B.T.S., Tamarack to NE has notch visible, Tamarack to NW has overgrowth of notch. Both in poor condition. Rotted post near.

10 This corner was set mid-point and on a line between ¼ corner north and section corner south.

C. Description of monument for corner and accessories established to perpetuate locating the position of the corner:

A-10 & 10: 1" pipe, 4" brass cap. **A-11:** 1" iron pipe, 3" brass cap.
All: bearings are magnetic

A-10	14" Hemlock (1/8) (NBT)	S61°W	22.1'
	4" Hemlock (1/8) (NBT)	S12°E	16.2'
A-11	5" Tamarack (S31) (NBT)	S13°E	31.2'
	4" Tamarack (S30) (NBT)	N55°E	25.5'
10	10" H. Maple (S 1/16) (BT)	S19°W	6.0'
	6" H. Maple (S 1/16) (BT)	N44°W	12.2'

SIGNED BY _____ DATE _____

SURVEYOR'S MICHIGAN REGISTRATION NO. _____ (SEAL)


FOR STATE AND UNITED STATES AGENCIES:

SIGNED BY _____ CHIEF OF SURVEY PARTY DATE 10-22-73

APPROVED AND SIGNED BY Frank J. Bray MICHIGAN REGISTERED LAND SURVEYOR DATE _____ (SEAL)


CORNER NUMBERING CODE DIAGRAMS FOR IDENTIFYING LAND CORNER RECORDATIONS AND INDEXING

FOR PUBLIC LAND SURVEY CORNERS IN THE
T. 47ⁿ, R. 22, 23^w (MENTIONED OVER)

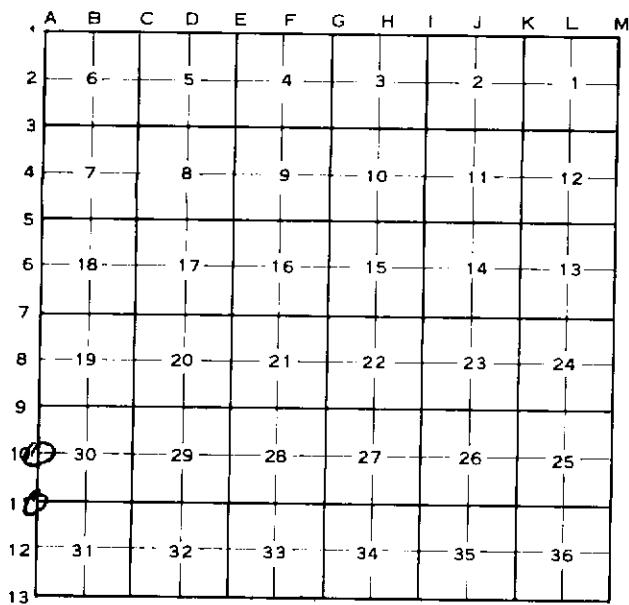

Apply letter prefix for corner points encircled above for identifying corner recordation numbers over.

FOR PROPERTY CONTROLLING AND MISC. PROPERTY CORNERS WITHIN THE SECTION (MENTIONED OVER AND EXCLUDE LOT CORNER)

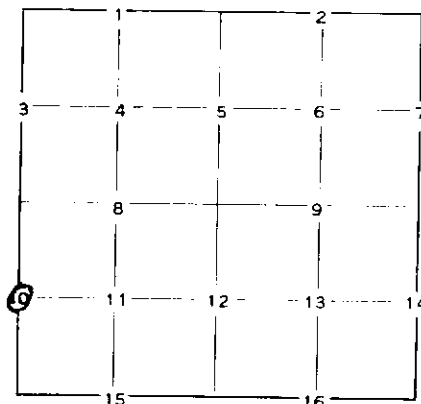

1. Above coded numbers are positioned on 1/16 fractional lines of the section.
2. Township corner code numbers shall be applied to corners of above typical section not numbered.
3. Miscellaneous property corners within a section, located at points other than numbered above, shall be referenced to at least two of above corner code numbers.
4. Private claim corners to be tied to rectangular land corners if possible - sketch required below.

EXPLANATORY SKETCH IF NECESSARY -- BELOW

