

DEC 27 1999

Approved by Alger County
Land Survey Remonumentation
Peer Group Under Act 346 of
P.A. of 1990 On 12-8-1999

Donald W. Kinnunen
Chairman

05-156

LAND CORNER RECORDATION CERTIFICATE
Filing Requirement of Act 74, Mich. P.A. 1970

For corners in
SECTION
Alger
(County)

	Located In:	Corner Code #
1. Public Land Survey	T 48N R 15W	B11
	T _____ R _____	_____
	T _____ R _____	_____
	T _____ R _____	_____
2. Property Controlling in Section	S _____ T _____ R _____	_____
	S _____ T _____ R _____	_____
3. Miscellaneous Property in Section	S _____ T _____ R _____	_____
	S _____ T _____ R _____	_____

FILED
TIME 1:30 p.m.


DEC 15 1999

DONALD W. KINNUNEN
REGISTER OF DEEDS
ALGER COUNTY, MI

Register of Deeds Stamp & File Number

- 4. Lot No. _____, Recorded Plat _____
- 5. Private Claims _____

I, Robert L. Jamros, in a field survey on September 24, 1999, 19 _____, do hereby state that under requirements of P.A. 74, Michigan P.A. of 1970, the corner points mentioned in lines 1 and 2 above were in conformance with regulations and rules therefore as required in the current manual of survey instructions of the United States Department of the Interior, Bureau of Land Management or by a decree of a Court of Law and/or that the corner points mentioned in lines 3, 4 and 5 above were in conformance with the rules of the Michigan Board of Land Surveyors or by a Decree of a Court of Law; established, re-established, monumented, recovered, found as expressed below:

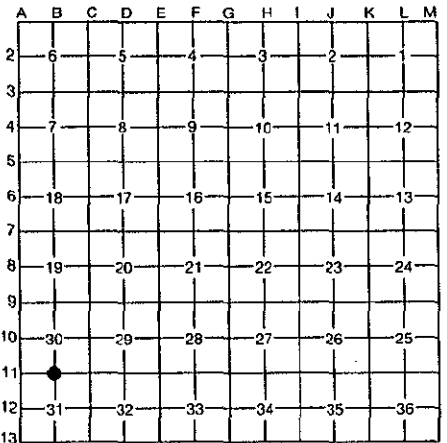

NOTE: Not more than 2 corners, all in the same town and range, may be recorded on this certificate.

A. Description of original monument and accessories and/or subsequent restoration:

B11: PLS * George E. Adair, DS, 1851. * Set quarter section post. * Sugar 9", N.17 1/2 E., 4 links. * Beech 10", S.18 W., 35 links. **** C.C.I.Co., Land and Timber Dept. * R.J. Brotherton, RLS, 1952. * No corner material described. * 20" Maple, S.63 W., 42 links. * 23" Hemlock (stump) N.19 W., 80 links. * Unrecorded.**** Robert L. Jamros, PS, 1987. * No monument found. * Established corner position from the information given in the notes of R.J. Brotherton, RLS, C.C.I. Co. * Established corner position from the existing remains of the reference trees of the 1952 report and measurements to existing corners 1/2 mile east, 1/4 mile west and 1/4 mile south. * Set 1/2"x25" rebar with I.D. cap. * Maple 10", N.12 W., 27.9 feet, "1/4s BT". * Maple 7", S.78 E., 23.8 feet, "1/4s BT". * Maple 6", S.22 E., 32.1 feet, "1/4s BT". * Maple 4", S.70 W., 18.1 feet, "1/4s BT". * Recorded in Liber 3, Page 353, Alger County Corner Records. * No other subsequent restoration of record.

B. Description of corner evidence found and/or method applied in restoring or reestablishing corner:

B11: Located corner position from previous survey. Found 1" steel rebar next to 1/2" rebar with I.D. cap, author unknown. Found all reference trees of the 1987 report in good condition with scribing visible. Checked position of existing monument with the record ties to corners east, west and south. Set new monument over 1/2" rebar and renewed existing reference trees. Corner monument as found is accepted as the best available evidence of the position of the original corner.

C. Description of monument for corner and accessories established to perpetuate locating the position of the corner:

B11: Set 2 1/2"x30" Berntsen aluminum monument No. A1NB30 with 3 1/4" aluminum cap stamped to identify corner position. * Renewed the following existing reference trees with BT signs and paint. * Set PK nails with aluminum I.D. washers for measure in the following: Existing - Maple 14", N.07 W., 27.94 feet. * Maple 12", N.82 E., 23.64 feet. * Existing - Maple 10", S.18 E., 32.11 feet. * Existing - Maple 6", S.78 W., 18.08 feet. * Survey marker sign on 6 foot steel post, N.52 W., 1.5 feet. * All bearings are magnetic.

Signed by *Robert L. Jamros*
Surveyor's Michigan License No. 25849

Date Dec 15 1999

