

DEC 27 1999

Approved by Alger County  
Land Survey Remonumentation  
Peer Group Under Act 345 of  
P.A. of 1990 On 12-8-99

Donald W. Carlson  
Chairman

For corners in SECTION

LAND CORNER RECORDATION CERTIFICATE  
Filing Requirement of Act 74, Mich. P.A. 1970

05-158

Alger (County)	Located In:	Corner Code #
1. Public Land Survey	T <u>48N</u> R <u>15W</u>	<u>C3</u>
	T _____ R _____	_____
	T _____ R _____	_____
	T _____ R _____	_____
2. Property Controlling in Section	S _____ T _____ R _____	_____
	S _____ T _____ R _____	_____
3. Miscellaneous Property in Section	S _____ T _____ R _____	_____
	S _____ T _____ R _____	_____
4. Lot No. _____, Recorded Plat _____		
5. Private Claims _____		


FILED  
TIME 1:30 p.m.

DEC 15 1999

DONALD W. KINNUNEN  
REGISTER OF DEEDS  
ALGER COUNTY, MI

Register of Deeds Stamp & File Number

I, Robert L. Jamros, in a field survey on July 23, 1999, 19\_\_\_\_\_, do hereby state that under requirements of P.A. 74, Michigan P.A. of 1970, the corner points mentioned in lines 1 and 2 above were in conformance with regulations and rules therefore as required in the current manual of survey instructions of the United States Department of the Interior, Bureau of Land Management or by a decree of a Court of Law and/or that the corner points mentioned in lines 3, 4 and 5 above were in conformance with the rules of the Michigan Board of Land Surveyors or by a Decree of a Court of Law; established, re-established, monumented, \_\_\_\_\_ recovered, found as expressed below:

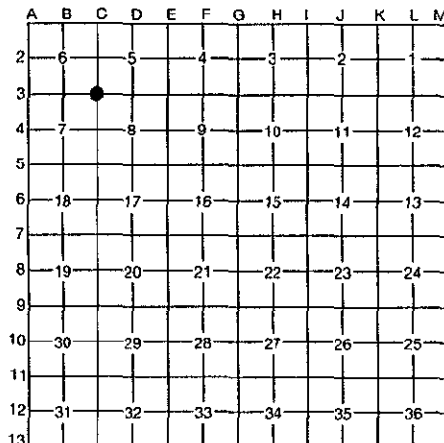

NOTE: Not more than 2 corners, all in the same town and range, may be recorded on this certificate.

A. Description of original monument and accessories and/or subsequent restoration:

C3: PLS \* George E. Adair, DS, 1851. \* Set post corner of Sections 5, 6, 7 and 8. \* Beech 7', N.80 W., 30 links. \* Beech 15', S.71 E., 31 links. \*\*\*\*\* No other subsequent restoration of record.

B. Description of corner evidence found and/or method applied in restoring or reestablishing corner:

C3: Located corner search area by calculated position and standard field survey. Found only a paint line running South from this position. Established corner position by extending line South from section corner and 1/4 section corner North of position at a distance proportional to the North 1/2 mile of section line. No evidence of post or original BT's. GLO distance to lake North of corner was 231 feet, measured 246 feet. GLO distance to lake East of corner was 66 feet, measured 85 feet. GLO distance to top of hill South of corner was 198 feet, measured was 210 feet, more or less. GLO distance to top of hill West of corner was 330 feet, measured was 340 feet, more or less. Corner position as established is accepted as a careful and faithful reestablishment of the position of the original corner.

C. Description of monument for corner and accessories established to perpetuate locating the position of the corner:

C3: Set 2 1/2"x30" Berntsen aluminum monument No. A1NB30 with 3 1/4" aluminum cap stamped to identify corner position. \* Established the following reference trees with BT signs, blazed, scribed and painted. \* Set PK nails with aluminum I.D. washers for measure in the following: Maple 8", S.82 W., 15.26 feet, "S7 BT". \* Maple 6", N.47 W., 32.81 feet, "S6 BT". \* Maple 10", N.73 E., 33.64 feet, "S5 BT". \* Maple 8", S.49 E., 32.83 feet, "S8 BT". \* Survey marker sign on 6 foot steel post, N.27 W., 1.3 feet. \* All bearings are magnetic.

Signed by Robert L. Jamros  
Surveyor's Michigan License No. 25849

Date Dec. 15, 1999

