

DEC 27 1999

Approved by Alger County  
Land Survey Re-monumentation  
Peer Group Under Act 345 of  
P.A. of 1990 On 12-8-99

*Donald W. Carlson*  
Chairman

05-160

For corners in SECTION LAND CORNER RECORDATION CERTIFICATE  
Filing Requirement of Act 74, Mich. P.A. 1970

Alger (County)	Located In:	Corner Code #
1. Public Land Survey	T 49N R 15W	C7
	T _____ R _____	_____
	T _____ R _____	_____
	T _____ R _____	_____
2. Property Controlling in Section	S _____ T _____ R _____	_____
	S _____ T _____ R _____	_____
3. Miscellaneous Property in Section	S _____ T _____ R _____	_____
	S _____ T _____ R _____	_____
4. Lot No. _____, Recorded Plat _____		
5. Private Claims _____		

FILED  
TIME 1:30 pm  
DEC 15 1999  
DONALD W. KINNUNEN  
REGISTER OF DEEDS  
ALGER COUNTY, MI  
Register of Deeds Stamp & File Number

A	B	C	D	E	F	G	H	I	J	K	L	M
2	6	5	4	3	2	1						
3												
4	7	8	9	10	11	12						
5												
6	18	17	16	15	14	13						
7		●										
8	19	20	21	22	23	24						
9												
10	30	29	28	27	26	25						
11												
12	31	32	33	34	35	36						
13												


I, Robert L. Jamros, in a field survey on October 12, 1999, 19\_\_\_\_\_, do hereby state that under requirements of P.A. 74, Michigan P.A. of 1970, the corner points mentioned in lines 1 and 2 above were in conformance with regulations and rules therefore as required in the current manual of survey instructions of the United States Department of the Interior, Bureau of Land Management or by a decree of a Court of Law and/or that the corner points mentioned in lines 3, 4 and 5 above were in conformance with the rules of the Michigan Board of Land Surveyors or by a Decree of a Court of Law; established, re-established, monumented, \_\_\_\_\_ recovered, found as expressed below:

NOTE: Not more than 2 corners, all in the same town and range, may be recorded on this certificate.

A. Description of original monument and accessories and/or subsequent restoration:  
C7: PLS \* George E. Adair, DS, 1851. \* Set post corner of Sections 17, 18, 19, and 20. \* Beech 6", N.76 E., 16 links. \* Beech 8", S.70 W., 19 links. \*\*\*\* Michigan Department of Conservation, Forestry Division. \* Dean C. DeLaMater, RLS, 1952. \* Corner set by double proportionate measurement, 1 possible BT still in place, badly rotted. \* Set 1" iron pipe with 4" brass cap. \* 30" W.Pine stump, N.55 W., 67 links. \* 26" W.Pine stump, N.63 E., 96 links. \* Liber 2, Page 28, Alger County Corner Records. \*\*\*\* No other subsequent restoration of record.

B. Description of corner evidence found and/or method applied in restoring or reestablishing corner:  
C7: Located corner search area by calculated position and standard field survey methods. Found 1" iron pipe with 4" brass cap and a 4" square post, 6' high with scribing, all in good condition. Also found BT of the 1952 report, 30" W.Pine stump, to be in good condition. The 26" W. Pine stump of the 1952 report is now a badly decayed stump. Established 4 new reference trees from monument position. Corner monument as found is accepted as a careful and faithful reestablishment of the position of the original corner.

C. Description of monument for corner and accessories established to perpetuate locating the position of the corner:  
C7: Existing 1" iron pipe with 4" brass cap. \* Established new reference trees with BT signs, blazed, scribed and painted. \* Set PK nails with aluminum I.D. washers for measure in the following: R.Pine 14", N.39 E., 55.63 feet, "S17 BT". \* R.Pine 11", S.44 E., 11.69 feet, "S20 BT". \* R.Pine 14", S.51 W., 74.08 feet, "S19 BT". \* R.Pine 12", N.40 W., 64.68 feet, "S18 BT". \* Survey marker sign on 6 foot steel post, S.48 W., 1.5 feet. \* All bearings are magnetic.

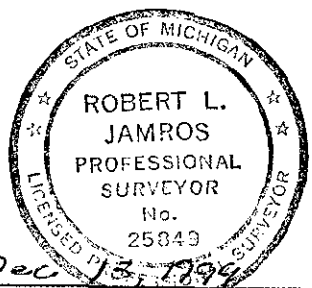

Signed by *Robert L. Jamros* Date Dec 13, 1999  
Surveyor's Michigan License No. 25849