

DEC 27 1999

Approved by Alger County Land Survey Reenumeration Peer Group Under Act 265 of P.A. of 1990 On 12-8-99

Guadalupe Carlson Chairman


05-161

For corners in SECTION

LAND CORNER RECORDATION CERTIFICATE Filing Requirement of Act 74, Mich. P.A. 1970

Table with columns: Alger (County), Located In:, Corner Code #. Rows include Public Land Survey, Property Controlling in Section, Miscellaneous Property in Section, Lot No., and Private Claims.

FILED TIME 1:30 p.m. DEC 15 1999 DONALD W. KINNUNEN REGISTER OF DEEDS ALGER COUNTY, MI Register of Deeds Stamp & File Number

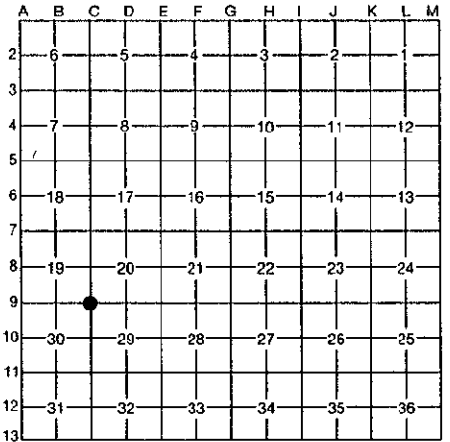

I, Robert L. Jamros, in a field survey on August 16, 1999, do hereby state that under requirements of P.A. 74, Michigan P.A. of 1970, the corner points mentioned in lines 1 and 2 above were in conformance with regulations and rules therefore as required in the current manual of survey instructions of the United States Department of the Interior, Bureau of Land Management or by a decree of a Court of Law and/or that the corner points mentioned in lines 3, 4 and 5 above were in conformance with the rules of the Michigan Board of Land Surveyors or by a Decree of a Court of Law; established, re-established, monumented, recovered, found as expressed below:

NOTE: Not more than 2 corners, all in the same town and range, may be recorded on this certificate.

A. Description of original monument and accessories and/or subsequent restoration:


C9: PLS * George E. Adair, DS, 1851. * Set post corner of Sections 19, 20, 29, and 30. * W.Pine 40", corner. * Y.Birch 12", N.36 W., 28 links. * Beech 9", S.16 E., 33 links. **** C.C.I. Co., Land Corner Record, unrecorded. * Ray J. Brotherton, RLS, 1949. * H.C. Lawrence, RLS, has scribed 5" post set in 40" W.Pine stump figured to be the Government corner tree. * No witnesses to corner given. **** Michigan Department of Conservation, Forestry Division. * Dean C. DeLaMater, RLS, 1953. * Corner had been previously located and perpetuated by H.C. Lawrence, RLS. * Corner is placed in 36" W.Pine stump. * Set 1" iron pipe with 4" brass cap. * 20" Hemlock, East, 27 links. * 20" Beech, S.52 W., 19 links. * Liber 2, Page 21, Alger County Corner Records. **** No other subsequent restoration of record.

B. Description of corner evidence found and/or method applied in restoring or reestablishing corner:

C9: Located corner search area by calculated position and standard field survey methods. Found 1" iron pipe with 4" brass cap in the center of a 40" decayed W.Pine stump. Also found only 1 BT of the 1953 report, 20" Hemlock, in good condition. Established additional reference trees. Corner monument as found is accepted as a careful and faithful perpetuation of the position of the original corner.

C. Description of monument for corner and accessories established to perpetuate locating the position of the corner:

C9: Existing 1" iron pipe with 4" brass cap. * Renewed existing BT with BT signs and paint. * Established new reference trees with BT signs, blazed, scribed and painted. * Set PK nails with aluminum I.D. washers for measure in the following: Existing - Hemlock 24", N.86 E., 18.38 feet. * Balsam 6", N.88 W., 11.97 feet, "S30 BT". * Hemlock 20", N.26 W., 47.70 feet, "S19 BT". * Hemlock 5", N.24 E., 15.72 feet, "S20 BT". * Survey marker sign on 6 foot steel post, S.21 W., 2.5 feet. * All bearings are magnetic.

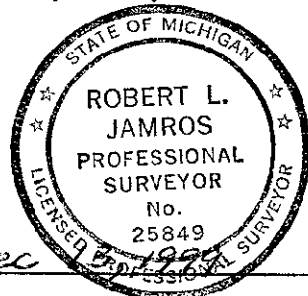

Signed by Robert L. Jamros Surveyor's Michigan License No. 25849

Date Dec