

DEC 27 1999

Approved by Alger County
Land Survey Remonumentation
Peer Group Under Act 245 of
P.A. of 1990 On 12-8-1999

Donald W. Kinnunen
Chairman

05-163

LAND CORNER RECORDATION CERTIFICATE
Filing Requirement of Act 74, Mich. P.A. 1970

For corners in SECTION

Alger
(County)

Located In:

Corner Code #

- 1. Public Land Survey T 48N R 15W C11
- T R
- T R
- T R
- 2. Property Controlling S T R
- in Section S T R
- 3. Miscellaneous S T R
- Property in Section S T R

FILED
TIME 1:30 p.m.

DEC 15 1999

DONALD W. KINNUNEN
REGISTER OF DEEDS
ALGER COUNTY, MI

Register of Deeds Stamp & File Number

- 4. Lot No. _____, Recorded Plat _____
- 5. Private Claims _____

A	B	C	D	E	F	G	H	I	J	K	L	M
2	6	5	4	3	2	1						
3												
4	7	8	9	10	11	12						
5												
6	16	17	16	15	14	13						
7												
8	19	20	21	22	23	24						
9												
10	30	29	28	27	26	25						
11		•										
12	31	32	33	34	35	36						
13												

I, Robert L. Jamros, in a field survey on September 24, 1999, 19_____, do hereby state that under requirements of P.A. 74, Michigan P.A. of 1970, the corner points mentioned in lines 1 and 2 above were in conformance with regulations and rules therefore as required in the current manual of survey instructions of the United States Department of the Interior, Bureau of Land Management or by a decree of a Court of Law and/or that the corner points mentioned in lines 3, 4 and 5 above were in conformance with the rules of the Michigan Board of Land Surveyors or by a Decree of a Court of Law; established, re-established, monumented, _____ recovered, found as expressed below:

NOTE: Not more than 2 corners, all in the same town and range, may be recorded on this certificate.

A. Description of original monument and accessories and/or subsequent restoration:


C11: PLS * George E. Adair, DS, 1851. * Set post corner of Sections 29, 30, 31, and 32. * W.Pine 11", N.29 W., 17 links. * Hemlock 20", S.35 E., 15 links. ***** Subsequent restoration by H.C. Lawrence, RLS, and Ray J. Brotherton, RLS, unrecorded. ***** Robert L. Jamros, RLS, 1987. * Found leaf spring set by Ray J. Brotherton to replace deteriorated post set by H.C. Lawrence. * Also found stump remains of GLO W.Pine BT. * Witness trees of the subsequent restoration still visible and in good condition. * Set 1/2"x18" rebar with RLS cap at existing leaf spring. * Established additional witness trees, blazed, scribed and painted. * Existing - Hemlock 20", S.67 W., 8.6 feet. * Existing - Maple 8', N. 70 E., 4.8 feet. * Maple 10" N.28 W., 22.4 feet, "S30 BT". * Maple 10" N.36 E., 16.1 feet, "S29 BT". * Liber 3, Page 353, Alger County Corner Records. ***** No other subsequent restoration of record.

B. Description of corner evidence found and/or method applied in restoring or reestablishing corner:

C11: Located corner search area by standard field survey methods. Found leaf spring and 1/2" rebar with RLS cap at corner position. Also found all 4 reference trees of the 1987 report in good condition. Installed new monument over existing monuments and renewed all reference trees. Corner monuments as found are accepted as a careful and faithful perpetuation of the position of the original corner.

C. Description of monument for corner and accessories established to perpetuate locating the position of the corner:

C11: Set over existing monuments a 2 1/2"x30" Berntsen aluminum monument No. A1NB30 with 3 1/4" aluminum cap stamped to identify corner position. * Renewed existing reference trees with BT signs and paint. * Set PK nails with aluminum I.D. washers for measure in the following: Existing - Maple 14", N.24 W., 22.49 feet. * Existing - Maple 14", N.44 E., 16.13 feet. * Existing - Maple 10", N.77 E., 4.81 feet. * Existing - Hemlock 20", S.77 W., 8.41 feet. * Survey marker sign on 6 foot steel post, S.65 E., 1.5 feet. * All bearings are magnetic.

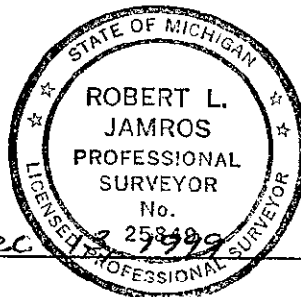

Signed by Robert L. Jamros
Surveyor's Michigan License No. 25849

Date Dec 2 1999